

*J. A. Hoffbuhr*  
 NOVEMBER 7, 1947  
**J. A. HOFFBUHR**  
 222

MAP OF SURVEY  
 LOCATED IN

D.L.C. NO. 90 & S.E. 1/4 SEC. 29, T.37S., R.2W., W.M.  
 JACKSON COUNTY OREGON

FOR  
 PETER FICK

J.A. HOFFBUHR L.S. MEDFORD, OREGON  
 SCALE: 1" = 100' 2-21-1966

BEARINGS PER R/S NO. 2519  
 O = SET 5/8" X 24" REINF. PIN

Survey Narrative To Comply With Paragraph 209.250  
Oregon Revised Statutes


SURVEY FOR: Peter Fick  
830 North Fifth Street  
Jacksonville, Oregon

LOCATION: Tract situated in Donation Land Claim No. 90  
and the Southeast One Quarter (1/4) of Section  
29, Township 37 South, Range 2 West, Willamette  
Meridian, Jackson County, Oregon.

PURPOSE: To monument and describe the boundaries of tract  
as indicated on the attached map.

PROCEDURE: The control of previous surveys by this office  
and other recorded surveys were used as indicated on the map of  
this survey. Basis of bearings--Recorded Survey No. 2519.

January 5, 1967

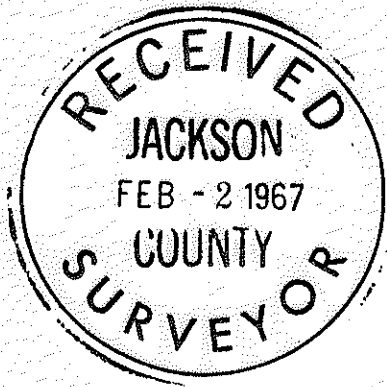

J.A. Hoffbuhr  
Registered Land Surveyor

