

SURVEY IN SW 1/4 SEC. 32 T36S, R1W, WM.
 W 1/2 SEC. 5 T36S, R1W, WM.
 FOR
 FAYDREX, INC.
 66-28

BY EDWARD A. MCGINTY
 MEDFORD OREGON
 AUGUST 1966

SCALE 1" = 200'
 0 = 5/8" IRON PIN



cont'd, page 2


For Faydrex, Inc.
By Edw. McGinty

- G. 1/4 Cor. between Secs. 29 and 32. - Found a 1 in. iron pipe, from which a white oak, 16 ins. diam., bears N. 40° 15' W., 67.2 ft. dist.
- H. Center of Sec. 32 - According to County survey records, found a 1 in. iron pipe, from which
Center of white oak, 14 ins. diam., bears N. 83° 00' E., 10.0 ft.
Center of oak stump, 12 ins. diam., bears S. 70° 20' W., 44.9 ft.
- I. Found County road dept. spikes, from said spike this line was projected northerly to the P. I., setting a 5/8" x 12" iron pin. Its location was determined from 1927 road survey fence line stations. (This was discussed with the County Engineer). The location of road tangent N. 18° 29' 20" E., the center line was determined with recommendation from County Engr. holding record distance to center line at the North 1/4 cor. of Sec. 32 which agrees to the existing conditions) and holding mean dist improvements near E. & W. center line of Sec. 32, then projecting said line southerly to the P. I.




Survey Narrative to comply with O.R.S. 209-250:

Survey for: Faydrex, Inc.
1054 So. Riverside Ave.
Medford, Oregon

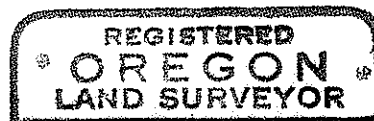

Survey by: Edward A. McGinty, L.S.
Medford, Oregon

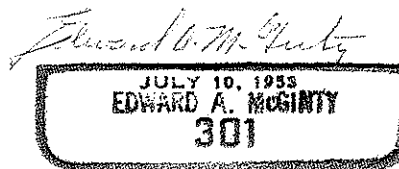

Buy 1966
Rev - Dec 1966

BASIS OF BEARING: Solar observation.

PRECEDENCE OF SURVEY:

- A. 1/4 cor. between Sec. 5 and 32, Found a 1 in. iron pipe 4 ins. high, from which,
 - Face of white oak, 8 ins. diam., bears S. 11° 00' E., 20.2 ft. dist.
 - Face of white oak, 20 ins., diam., bears S. 54° 45' W., 45.4 ft.
(record S. 52° W., 44.88 ft.)
 - Center of white oak, 18 ins., diam. bears N. 21° 15' E., 62.1 ft. dist.
 - Center of white oak, 20 ins. diam., bears N. 45° 10' W., 77.0 ft. dist.
- B. 1/4 cor. between Sec. 4 and 5 - Found a 1 in. pipe & brass cap mkd. Co. Sur. 1960.
- C. 1/4 cor. between Sec. 5 and 8 - Found a 1 in. iron pipe, 5 ins. high, from which
 - Center of White oak, 12 ins. diam., bears S. 4° 40' E., 100.5 ft. dist.
 - Center of white oak, 14 ins. diam., bears N. 44° 20' E., 99.2 ft. dist.
 - Center of white oak stump, 30 ins. diam., bears S. 17° 00' W., 58.6 ft.
- D. Corner of Secs. 6, 7 and 8. - Search for stone, dug hole 2 ft. by 2 ft., approx. 3 1/2 ft. deep.
 - Set a 5/8 in. x 30 in. iron pin, 5 ins. deep for corner, from which
 - Center of White oak, stump, 20 ins. diam., bears S. 47° 05' W., 210.7 ft.
 - Center of White oak, 15 ins. diam., bears N. 11° 09' W., 220.8 ft. dist.
 - Center of White oak stump, 40 ins. diam., bears N. 18° 25' E., 202.8 ft.
 - Set a 3/4 in. iron pipe, S. 87° 50' W., 21.33 ft.
- E. Corner of Secs. 5, 6, 31 and 32. - Found a rock mound, remains of old stake next to fence post. Set a 5/8 in. x 30 ins. iron pin flush in said rock mound from which
 - Center of white oak, 24 ins. diam., bears S. 47° 20' West, 30.95 ft. dist.
 - Center of stump hole, yellow pine, bears N. 2° 40' E., 32.35 ft. dist.
- F. 1/4 cor. between Sec. 31 & 32 - Found a 1 in. pipe, 8 ins. high, from which
 - Face of white oak, 24 ins. diam., bears S. 81° 30' W 77.4 ft.
 - Face of white oak, 20 ins. diam., bears N. 55° 30' W 119.5 ft.

(cont'd next page)