

3340  
0788'



FD. 1" IRON PIPE  
SW COR. LOT 8, BLK. 1

WEST  
223.77'  
PLAT 224.28'

S 22° 52' 45" E  
162.81'

0.66 ACRES

EAST  
160.00'

FD. 1" IRON PIPE  
NE COR. LOT 1, BLK. 1

FD. 1" IRON PIPE  
SE COR. LOT 8, BLK. 1  
NE COR. LOT 2, BLK. 4

N 0° 10' 50" E  
150.00'

SURVEY IN LOT 2, BLOCK 4  
CLYMER HEIGHTS SUBDIVISION  
D.L.C. 42, T.38S., R.2 W., W.M.  
JACKSON COUNTY, OREGON

FOR

LELAND J. KNOX


SCALE 1" = 50'

SURVEY BY

CHARLES H. HURST  
MEDFORD, OREGON

LEGEND

● SET 5/8" X 24" IRON PINS

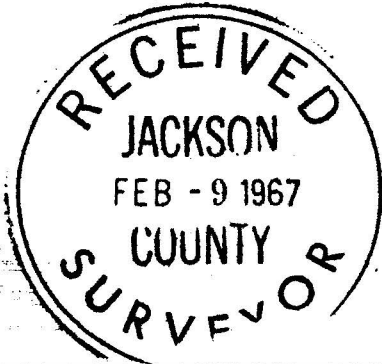

*Charles H. Hurst*



DEC 8 1966

.3340

Survey for: Leland J. Knox  
3165 Hyacinth Drive  
Medford, Oregon

Survey by : Charles H. Hurst, L.S.  
765 Sunrise Avenue  
Medford, Oregon

Bearing : Based on the meridian of Clymer Heights Subdivision


Purpose : To separate the tract shown from Lot 2, Block 4 of  
the Clymer Heights Subdivision.

PROCEDURE

The east boundary of Clymer Heights Subdivision was raised as monumented from the southeast corner of Block 1 to the northeast corner of Block 1 and produced southerly 150.00 feet.

The tract shown was surveyed with the south boundary being parallel to the north boundary of Block 4 holding a 2" iron pipe at the southwest corner of Lot 8, Block 1 for control.

December 8, 1966

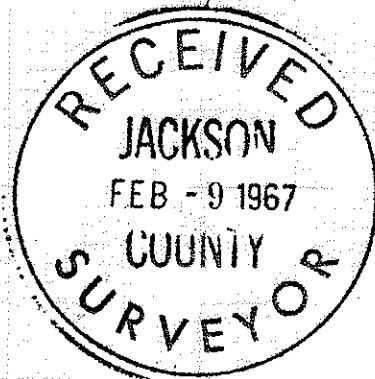

*Charles H. Hurst*

