

NORTH 1/16 SEC. COR.
SECS. 19 & 20 FOUND
3/4" IRON PIPE

RECORDED SURVEY NO. 2443

FOUND 1/2" IRON PIPE
N 0° 10' 00" W
1.40'

FOUND 1/2" GALV. IRON PIPE


EAST 300.00'

400.00'
43.52'

FOUND 3/4" GALV. IRON PIPE

S 86° 26' 00" W 150.265'

181.02'
S 0° 10' 00" E
(REC. SOUTH)

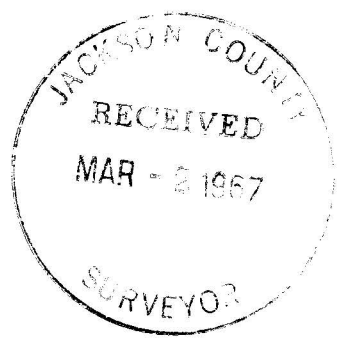

WEST 75.00'

REGISTERED
OREGON
LAND SURVEYOR

J. A. Hoffbuhr

NOVEMBER 7 1947
J. A. HOFFBUHR
222

(REC. NORTH)
N 0° 10' 00" W 523.14'

WABASH AVENUE

289.25'
S 0° 10' 00" E
(REC. SOUTH 285')

934.33'

S 0° 10' 00" E

MAP OF SURVEY
LOCATED IN
N.E. 1/4 SEC. 19, T. 37 S., R. 1 W., W.M.
JACKSON COUNTY, OREGON
FOR
MARGARET ALLEY

J. A. HOFFBUHR, REG. L.S., MEDFORD, OREGON
SCALE: 1" = 60' DECEMBER 14, 1966
BASIS OF BEARING- R/S NO. 2122
o = SET 5/8" X 24" STEEL REINF. PIN

CHISEL "X" FOR PROPERTY COR.
ON 3" X 4" CONC. IRRIGATION BOX

WEST 75.00'

WEST 225.00'

WOODROW LANE

FOUND 5/8" IRON BOLT

FOUND 5/8" IRON BOLT

RECORDED SURVEY NO. 2550

FOUND 5/8" IRON BOLT

RECORDED SURVEY NO. 2122

FOUND 5/8" IRON PIN

391.19'
19' 20'

1/4 SEC. COR. FOUND
1" GALV. IRON PIPE

3349
6488

3349

SURVEY NO. 3349

SURVEY NARRATIVE TO COMPLY WITH PARAGRAPH 209.250
OREGON REVISED STATUTES

SURVEY FOR: Margaret Alley
124 Greenway Circle
Medford, Oregon

LOCATION: Tract situated in the Northeast One Quarter
(1/4) of Section 19, Township 37 South, Range
1 West, Willamette Meridian, Jackson County,
Oregon.

PURPOSE: To monument and describe the tract of land as
shown on the attached map.

PROCEDURE: The East line of Section 19 between the East
One Quarter (1/4) Corner and the North One Sixteenth (1/16) Corner
on said Section Line was traversed as shown. The control from
previous recorded surveys was correlated with the record to
determine the boundary lines as indicated. Monuments found are as
also indicated on the attached map. Basis of bearings - Recorded
Survey No. 2122.

February 24, 1967

J. A. Hoffbuhr
Registered Land Surveyor

