
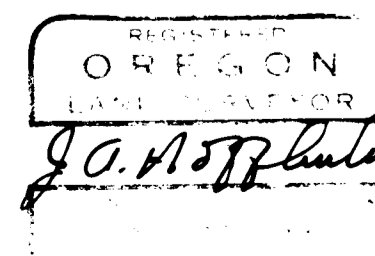


MAP OF SURVEY
 LOCATED IN
 SE 1/4 SEC. 8, SW 1/4 SEC. 9, NW 1/4 SEC. 17 & THE NE 1/4 SEC. 16, T.38 S., R. 1W., W.M.
 JACKSON COUNTY OREGON
 FOR
HERMAN MARRS

J. A. HOFFBUHR, REG. L.S., MEDFORD, OREGON
 SCALE: 1"=100' JUNE 19, 1966
 BASIS OF BEARING R/S NO. 2584
 ○ = SET 5/8" X 24" STEEL REINF. PIN

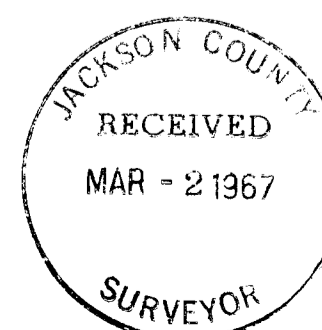

Survey Narrative To Comply With Paragraph 209.250
Oregon Revised Statutes

SURVEY FOR: Herman Marrs
2211 Houston Road
Medford, Oregon

LOCATION: Tract is situated in the Southeast One Quarter (1/4) of Section 8, the Southwest One Quarter (1/4) of Section 9, the Northwest One Quarter (1/4) of Section 17 and the Northeast One Quarter of Section 16, Township 38 South, Range 1 West, Willamette Meridian, Jackson County, Oregon.

PURPOSE: To partition into tracts, monument the corners and describe the parcels as shown on the attached map.

PROCEDURE: The section line common to Sections 16 and 17 was traversed and the monuments shown as found were accurately placed. The Jackson County Road Department control was used to locate Coleman Creek and Houston Roads. It was the purpose of this survey to carry out the intent of the record descriptions and the variances between the survey and the record perimeter boundary are as noted. Basis of bearings--Recorded Survey No. 2584.

January 5, 1967

J.A. Hoffbuhr
Registered Land Surveyor

