

REGISTERED
 OREGON
 LAND SURVEYOR

Edward A. McGinty

JULY 10, 1953
 EDWARD A. MCGINTY
 301

JACKSON COUNTY
 RECEIVED
 MAR 29 1967
 SURVEYOR

SURVEY IN ROGUE ACRES SUBD.
 IN SEC. 3 T.34S. R.1W, WM.

FOR

HAROLD JEWETT

67-1

BY EDWARD MCGINTY
 MEDFORD OREGON
 JANUARY 1967

SCALE 1"=100'

● = 5/8" I. PIN SET

○ = 3/4" I. PIPE FD.

⊙ = 1" I. PIPE FD.

Survey No. 3384


Survey Narrative to comply with O.R.S. 209-250:

Survey for: Harold Jewett
Shady Cove, Oregon
97539

Survey by: Edward A. McGinty, L.S.
Medford, Oregon
Jan. 1967



Edward A. McGinty

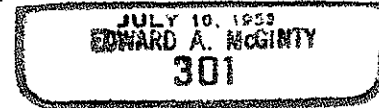

BASIS OF BEARING: Rogue Acre Sub-division.

PRECEDENCE OF SURVEY:

Found lot corners as shown, made a quick search for monuments that were found or set on Survey No. 2366 without any results. According to local resident, all monuments were destroyed in the 1964 flood. However, he stated that Mr. Whister did try to re-set the SSW. cor. lot #16 with an iron pin. In as much as the client was interested in only determining the southerly line of Lot. #14, within a few inches, a 5/8 inch iron pin was set near the SW corner of Lot #14 at approx. the same proportional distance measured on Lot #13. Held to record angles and bearing to set referance points.

