


Survey For:
 MOBIL OIL CORP.
 Located in the S.W. 1/4,
 Sec. 18, T.37S.R.1W., W.M.
 By: Mark E. Boyden
 May 1, 1967

3437
 L87E

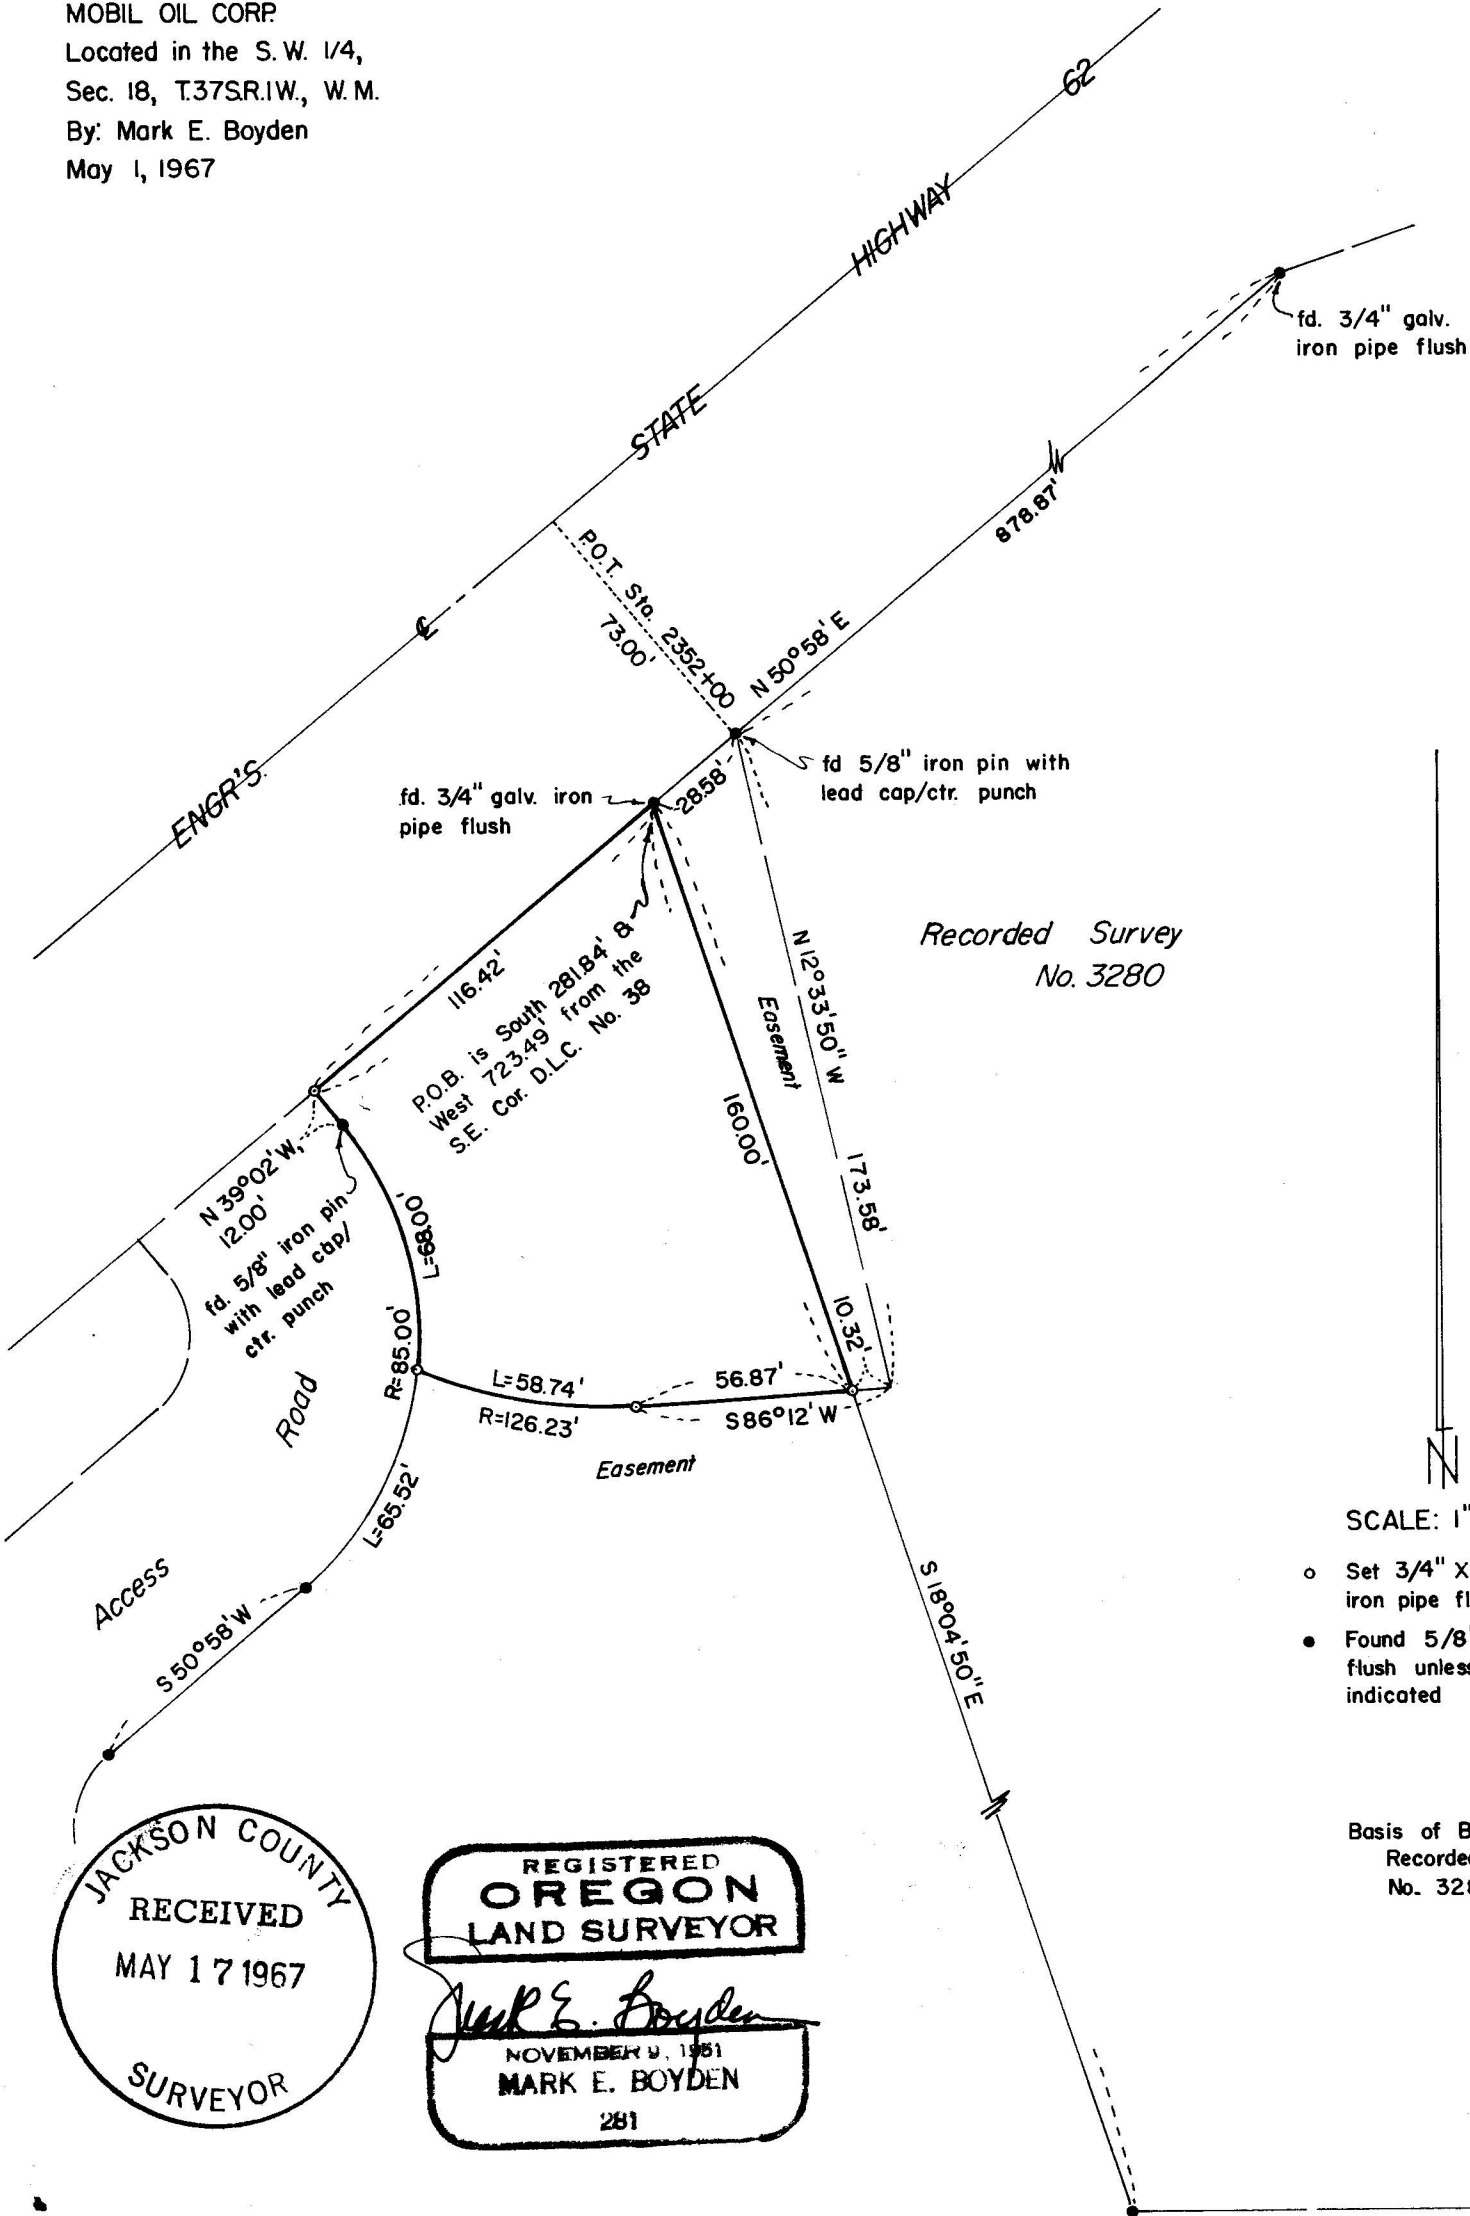

Recorded Survey
 No. 3280

SCALE: 1" = 50'

- Set 3/4" X 36" galv. iron pipe flush
- Found 5/8" iron pin flush unless otherwise indicated

Basis of Bearings:
 Recorded Survey
 No. 3280

JACKSON COUNTY
 RECEIVED
 MAY 17 1967
 SURVEYOR

REGISTERED
 OREGON
 LAND SURVEYOR

Mark E. Boyden
 NOVEMBER 9, 1961
 MARK E. BOYDEN
 281

3437

SURVEY NARRATIVE TO COMPLY WITH O.R.S. 209.250

FOR: Mobil Oil Corporation
P. O. Box L6118
Portland, Oregon 97231

PURPOSE: (1) To monument and describe a tract lying within the parcel surveyed for William P. McComas on Recorded Survey No. 2498
(2) To describe an easement lying Easterly from the above-mentioned tract.

PROCEDURE: Found State Highway Department monuments and monuments previously found or set on Recorded Survey Nos. 3280 and 3303 as shown. Monumented the additional tract corners as indicated.

May 1, 1967

