

SURVEY NARRATIVE TO COMPLY WITH PARAGRAPH 209.250
OREGON REVISED STATUTES

Survey for: A. William Erickson
2049 Orchard Home Drive
Medford, Oregon

Survey by: Charles H. Hurst, L.S.
765 Sunrise Avenue
Medford, Oregon

Bearing: Meridian based on government record for the north
boundary of Section 35, T. 34 S., R. 1 E., W. M.

Purpose: Define the north boundary of Section 35 and set the
West 1/16 corner common to Sections 26 and 35.



PROCEDURE

Ran the west half mile on the north boundary and set the West 1/16 corner by offset from random line. Government record is North $89^{\circ}48'$ West 2638.68 feet.

Set a $3/4$ "x30" iron pin for corner from which a $14\frac{1}{2}$ " Black oak bears North 6° East 33.77 feet scribed "W 1/16 S26 483 BT"; a 21" Ponderosa pine bears South $61^{\circ}30'$ East 34.98 feet scribed "W 1/16 S35 483 BT"; a $3/4$ " iron pipe bears North $63^{\circ}04'$ West 1.38 feet.

The corner to Sections 26, 27, 34 and 35, a 2" iron pipe, bears North $89^{\circ}48'$ West 1323.65 feet; the 1/4 corner common to Sections 26 and 35, a 1" iron pipe, bears South $89^{\circ}48'$ East 1323.65 feet. Said pipe is bent southerly but checks the re-establishment record, i.e. a 19" White oak bears North 49° East 116.08 feet to face; a 16.3" White oak bears South $72^{\circ}10'$ West 118.18 feet to face; deflection angle between the two bearing trees at corner is $23^{\circ}10'$.

Survey completed May 10, 1967.

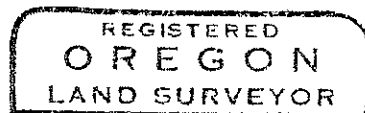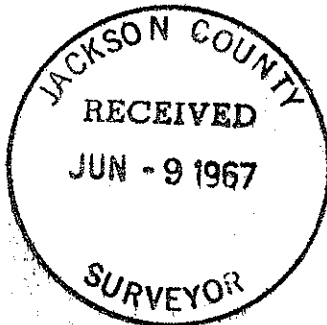

Charles H. Hurst

