



1783-3471

SURVEY FOR DONALD BOYD


Block 8, Original Town of

Jacksonville, Oregon


June 20, 1967

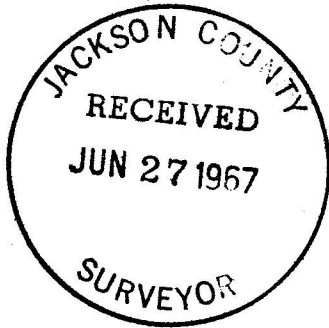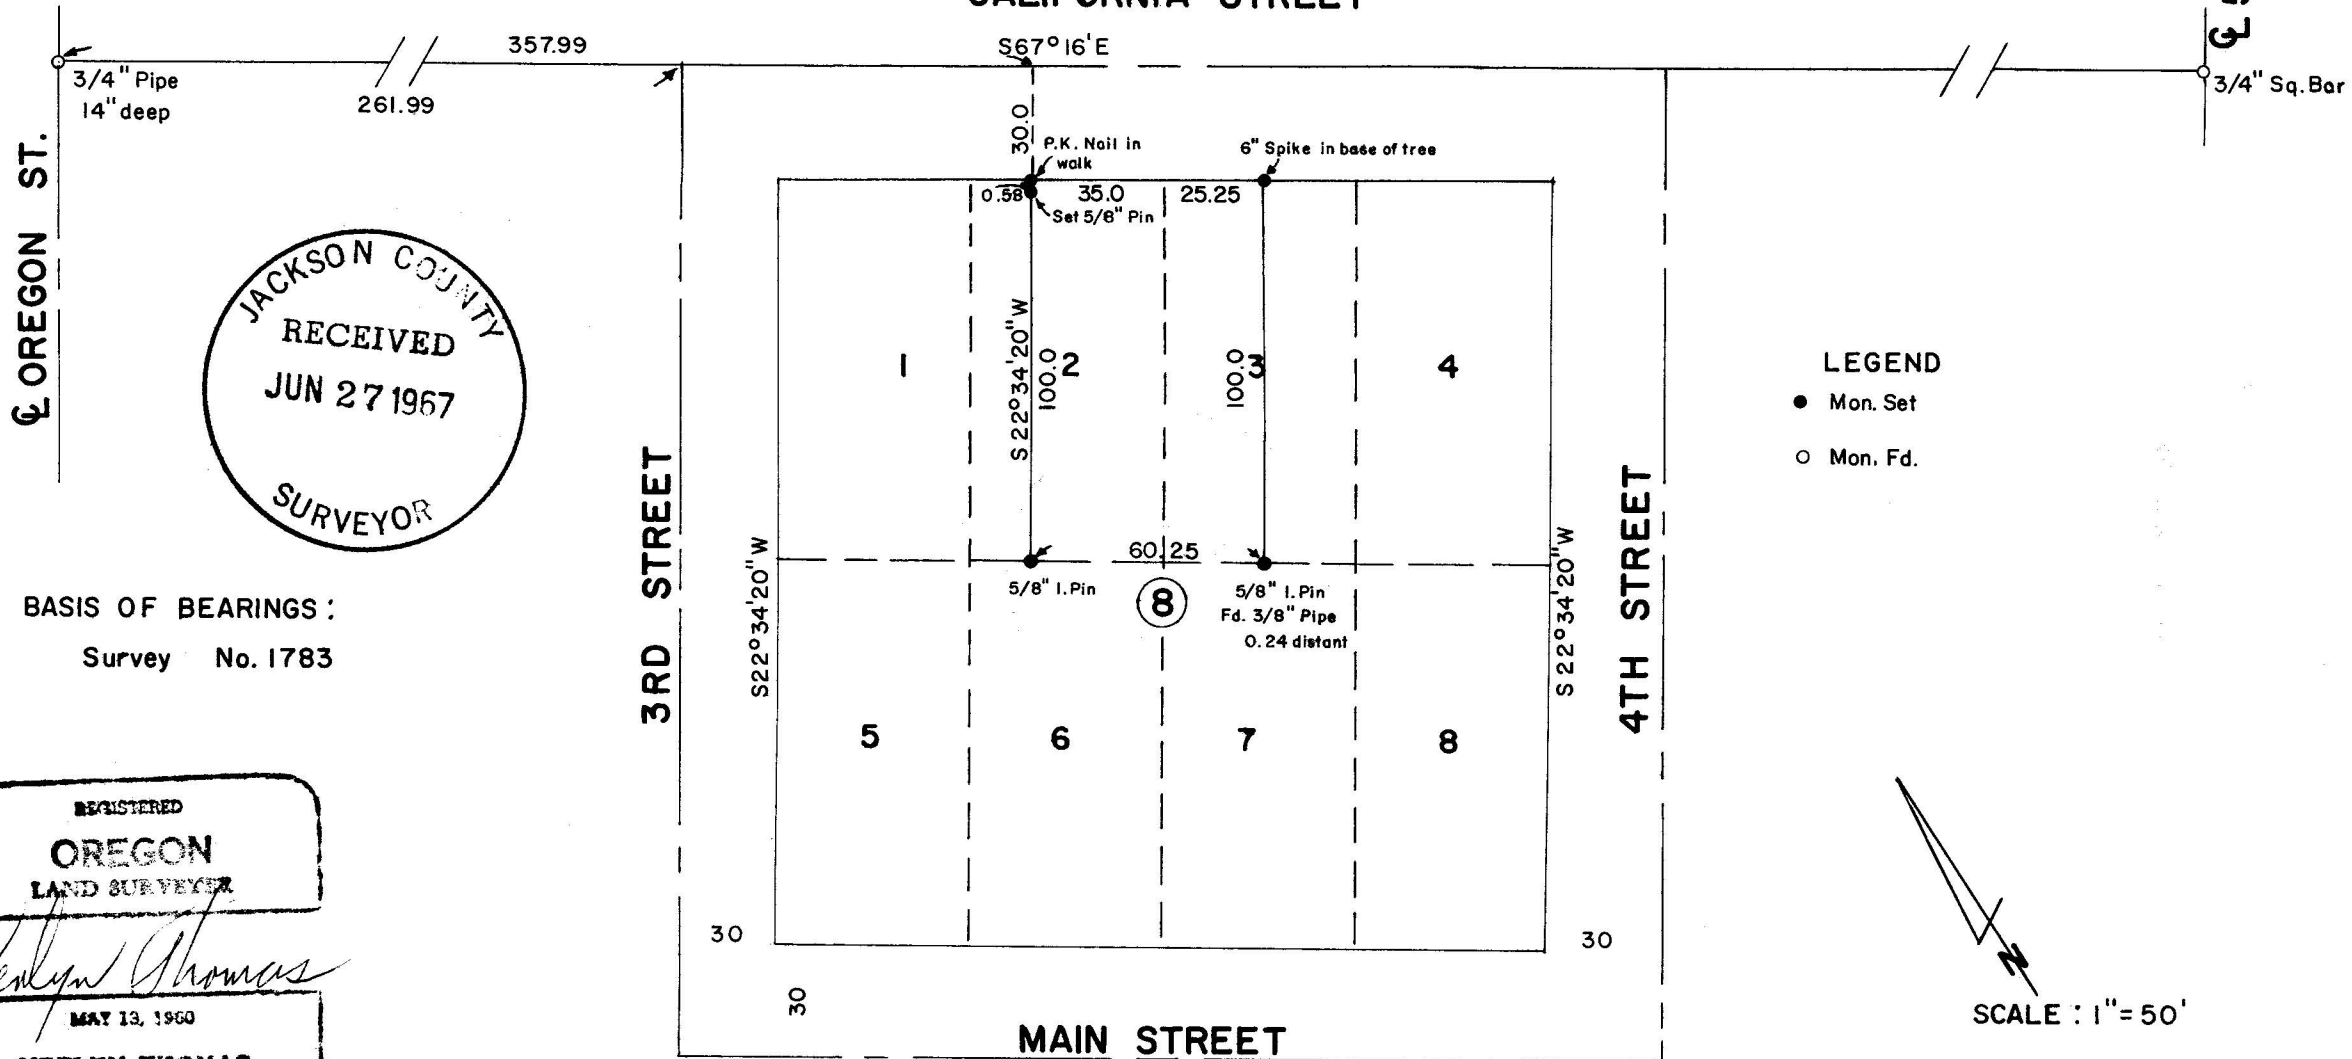

BASIS OF BEARINGS :
Survey No. 1783

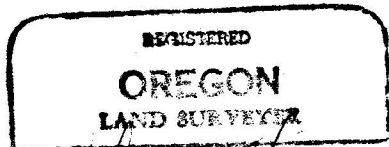

Verlyn Thomas

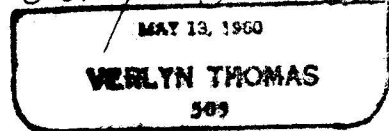

SURVEY NARRATIVE TO COMPLY WITH O.R.S. 209.250
REVISED BY CHAPTER 555, O.L. 1963

FOR: Donald Boyd
201 South Rose
Phoenix, Oregon

PURPOSE: To survey and monument a commercial parcel in Jacksonville, according to legal description furnished.

PROCEDURE: Recovered street monuments as shown on accompanying plat. Used bearing control for streets, and pro-rate data as indicated by Recorded Survey No. 1783, which has reestablished basic control in area. Recovered 3/8" iron pipe set in Recorded Survey 674, as indicated.

