

MAP OF SURVEY
 LOCATED IN
 S.E. 1/4 OF SEC. 10 AND THE N.E. 1/4 OF SEC. 15, T. 38 S., R. 1 W., W.M.
 JACKSON COUNTY OREGON
 FOR
 LEEVER REAL ESTATE

J. A. HOFFBUHR, REG. L.S., MEDFORD, OREGON
 SCALE: 1"=100' MARCH 30, 1967
 BASIS OF BEARING SOLAR OBSERVATION
 SET 5/8" X 24" IRON REINFORCING PIN

JACKSON COUNTY
 RECEIVED
 JUL - 7 1967
 SURVEY

REGISTERED
 OREGON
 LAND SURVEYOR
J. A. Hoffbuhr
 NOVEMBER 7, 1947
 J. A. HOFFBUHR
 222

3482

3482

Survey Narrative To Comply With Paragraph 209.250
Oregon Revised Statutes

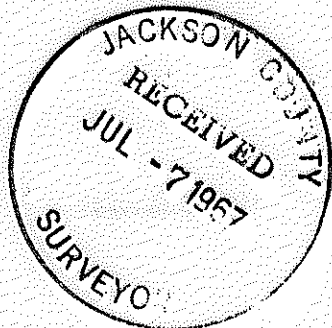
SURVEY FOR: Leever Real Estate
328 South Central Avenue
Medford, Oregon

LOCATION: Tract situated in the Southeast Quarter of Section 10 and the Northeast Quarter of Section 15, Township 38 South, Range 1 West, Willamette Meridian, Jackson County, Oregon.

PURPOSE: To monument the corners and describe the three parcels of land as indicated on the attached map in addition to the centerline description of the access road and water line right of way easement.

PROCEDURE: The line between the interior "El1" Corner of Donation Land Claim No. 42 and the 1 inch axle at the Northeast Corner of the South 1/2 of said Donation Land Claim was surveyed and used for control for the northerly portion of the West Line of the tract as shown, the southerly portion of the line was determined by locating the Easterly right of way line of Oregon State Highway Department Interstate Highway No. 5, the southerly and easterly lines of the tract surveyed was determined by the client. The north line was located on the record line. The Donation Land Claim Line between the interior "El1" Corner and the East Northeast Corner of said Donation Land Claim was traversed to determine the southerly line of the water well site. The East line of the said site was located on the existing property line which falls west of the record line.

June 21, 1967

J. A. Hoffbuhr
Registered Land Surveyor