

SURVEY IN BLK 5 EHRMAN WAREHOUSE INDUSTRIAL DISTRICT
 SEC. 14 T.37 S. R.2 W., W.M.

FOR
 AMERICAN SHEET METAL WORKS INC.

67-18

BY EDWARD MCGINTY
 MEDFORD OREGON
 JUNE 1967

SCALE 1"=100'
 O = 3/4" PIPE FD.
 ● = 5/8" PIN FD.

REGISTERED
 OREGON
 LAND SURVEYOR

Edward A. McGinty

JULY 10, 1958
 EDWARD A. MCGINTY
 301


JACKSON COUNTY
 RECEIVED
 AUG 11 1967
 SURVEYOR

Survey No. 3507

Survey Narrative to comply with Chap. 555 - O. L. 1963.

Survey for: American Sheet Metal Work, Inc.
Attn: Mr. Frank Foystar
920 N. E. Gleason Street
Portland, Oregon

Survey by: Edward A. McGinty, L.S.
Medford, Oregon
June 1967

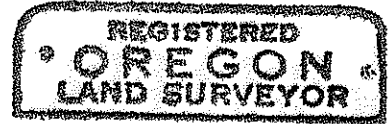

Edward A. McGinty



Basis of Bearing: None

Precedence of survey:

This survey is a partial retracement of survey No. 2134 - finding the original monuments of Ehrman Warehouse Industrial Dist. being 3/4 inch iron pipe, approx. 3 in. to 6 in. deep.

Point A - apparently bent Northerly.

Finding 5/8 in. iron pin at the NW and SW corner of tract surveyed.

