SURVEY FOR JOSEPH A. ALBACHTEN, ASHLAND, OREGON.


- LOCATION-

LOT 33 & N'/2 OF LOT 35, ASHLAND ACRES, D.L.C. #47 & SECTION 3, T. 395., R.I.E., W.M., JACKSON COUNTY, OREGON.

- • = MONUMENTS FOUND AS DESCRIBED
 - · = MONUMENTS SET AS DESCRIBED

DATE : AUGUST, 1966

SCALE: 1" = 200

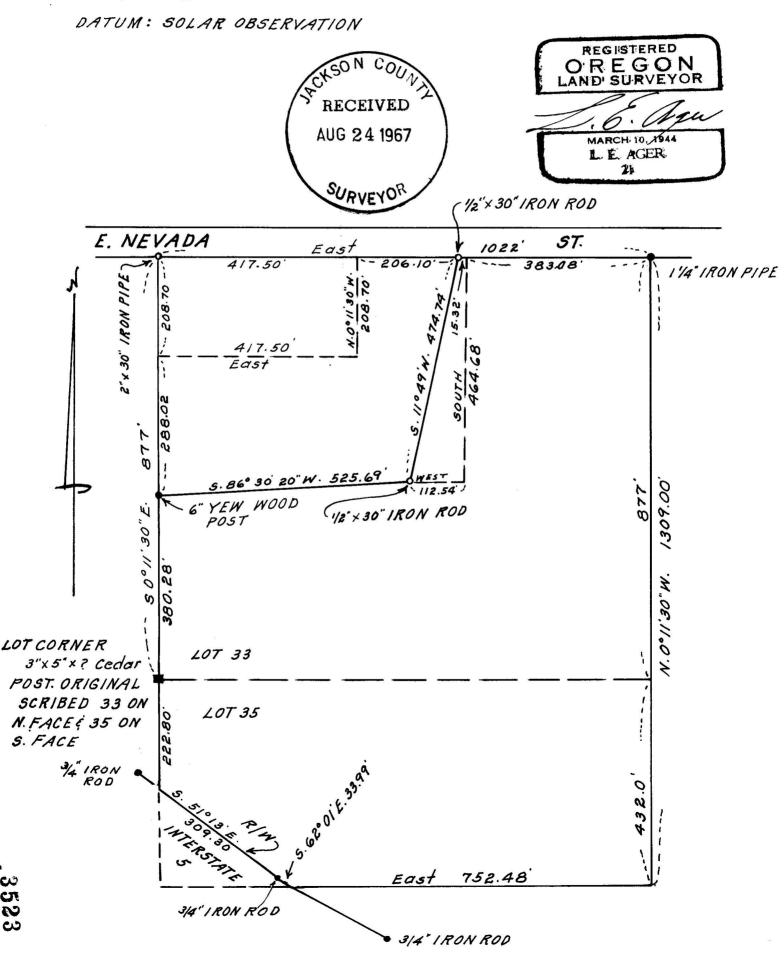

SURVEY NARRATIVE TO COMPLY WITH PARAGRAPH 209.250 OREGON REVISED STATUTES

SURVEY FOR: Joseph A. Albachten, 990 Nevada St.

Ashland, Oregon.


LOCATION: Lot 33 and N/2 of Lot 35, ASHLAND ACRES in D.L.C. # 47

and Section 3, all in T. 39 S., R. 1 E., W.M., Oregon.

PURPOSE: To monument the corners of tracts shown.

PROCEEDURE: At the northeast corner of Lot 33 I found an iron pipe as shown from which I measured westerly 1022.0 feet, the record distance of the north line of said Lot 33. From the post at the southwest corner of said Lot 33, I measured northerly 877.0 feet and set a 2" + 30" iron pipe at a point 1022.0 feet West of the northeast corner of said Lot and N.0011'30" W. 877.0 feet from the southwest corner thereof for the northwest corner thereof. Other points set according to map.

Solar taken Wed. July 6th at 9:00 A.M., P.S.T. 1966
Sun apparent decl. 22°41.5', Adj. Vert. angle* 45°22.5'
Computed bearing of sun = S. 79°45'50" E.

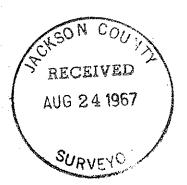

REGISTERED OREGON LAND SURVEYOR

MARCH 19/1944
L. E. ACER
21