

OLD PACIFIC HIGHWAY (U.S. 99) 1

MAP OF SURVEY
LOCATED IN
N.W. 1/4 OF SECTION 22, T. 36S
LOTS 10, 11 & 12 BLOC
TO THE ORIGINAL TOWN OF
JACKSON COUNTY ORE
FOR
CLIFTON E. SNE

J. A. HOFFBUHR, REG. L.S., MEDF
SCALE: 1" = 20'
BASIS OF BEARING -
• SET 3/8" X 24" IRON REINFO

REG. NO. 1401
RE: R/S 100.00 ft

E 2nd AVENUE
N 77° 20' 00"E 300.00' (REC. 300.00')

E 3rd STREET 2
N 77° 20' 00"E 25'

E 1st AVENUE
N 77° 20' 00"E 100.00' (REC. N 12° 40'E)

2nd STREET (VACATED)
N 12° 41' 40"E 100.00'


ORIGINAL TOWN
OF GOLD HILL
12
11
10

SOUTHERLY R/W LINE OLD PACIFIC HIGHWAY
N 77° 20' 00"E (REC. 78.0) 78.00'

N 12° 41' 40"E 160.00' (REC. 912° 40'W)

RECEIVED
AUG 24 1967
SURVEYOR

23

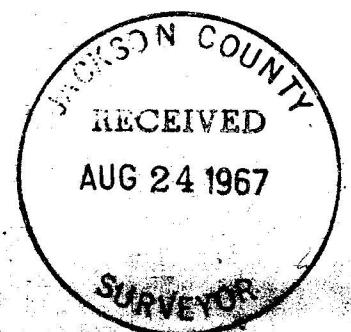

**MAP OF SURVEY
LOCATED IN
N.W. 1/4 OF SECTION 22, T. 38 S., R. 3 W., M.M. 2.
LOTS 10, 11 & 12 BLOCK 23
TO THE ORIGINAL TOWN OF GOLD HILL
JACKSON COUNTY OREGON
FOR**

CLIFTON E. SNELSON
J. A. HOFFBUHR, REG. L.S., MEDFORD, OREGON
SCALE: 1"=20' JUNE 20, 1966
BASIS OF BEARING— ORIGINAL TOWNSHIP
••• SET 5/8" X 24" IRON REINFORCING PIN

SURVEY NO. 3525

Survey Narrative To Comply With Paragraph 209.250
Oregon Revised Statutes

SURVEY FOR: Clifton E. Snelson
9031 John Day Drive
Central Point, Oregon

LOCATION: Lots 10, 11, and 12, Block 23 of the Original
Town of Gold Hill, Oregon and adjacent parcels.

PURPOSE: To monument the corners of the tract of land
shown on the attached map.

PROCEDURE: The monumented street control established by
Recorded Survey No. 1401 was used to establish the boundaries
of the tract as indicated. No evidence of the original control
could be found. Basis of bearings--Original Town Plat of Gold Hill.

August 15, 1967

J. A. Hoffbuhr
Registered Land Surveyor

