

2" IRON PIPE  
S.W. COR. D.L.C. #63, T.38S., R.1W., W.M.

SURVEY FOR: DELBERT E. JOHNSON  
3985 MILL ST.  
EUGENE, OREGON.

LOCATION: D.L.C. #66, SESW. SEC. 27 & NENW. SEC. 34,  
T.38S., R.1W., W.M., JACKSON COUNTY,  
OREGON.


● = 3/4" IRON PIPES FOUND UNLESS SHOWN  
OTHERWISE.

○ = 1/2" x 24" IRON RODS SET FLUSH

DATUM: SOLAR

DATE: 7-17-67

SCALE: 1" = 200'

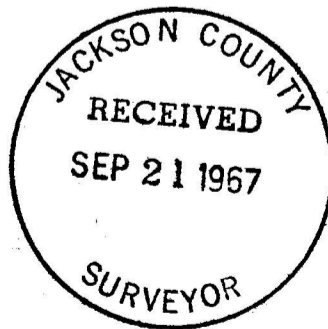

REGISTERED  
OREGON  
LAND SURVEYOR

*L. E. Ager*

MARCH 10, 1944  
L. E. AGER  
21

S.W. COR. D.L.C. #66, T.38S., R.1W., W.M.

N.W. COR. D.L.C. #67, T.38S., R.1W., W.M.

1 5/8" IRON PIPE  
S. 89° 42' E. 1234.20'  
ANDERSON CREEK ROAD  
S. 89° 42' E. 1/2" IRON PIPE

SURVEY NARRATIVE TO COMPLY WITH PARAGRAPH 209.250  
OREGON REVISED STATUTES

SURVEY FOR: Delbert E. Johnson  
3985 Mill St.  
Eugene, Oregon

LOCATION: D.L.C. # 66, SESW Sec. 27 & NENW Sec. 34, T.38S., R. 1 W.

PURPOSE: To monument the corners of tracts of land shown on map.

PROCEDURE: The beginning point of the tract of which this survey is a part of was on the south line of D.L.C. # 66. The south line of said claim established on a direct line between the monument found for the SW corner of D.L.C. # 66 and the monument found for the NW corner of D.L.C. # 67.

Boundary of tracts and ties to other monuments as shown on map.

Bearing Datum: Solar Obs.

Solar taken on true line, South line D.L.C. # 66.

Date: Monday June 26, 1967 at 4:00 P.M., P.S.T.

Sun App. Decl.  $23^{\circ}21.8'$  Adj. Vert. Angle:  $40^{\circ}23'30''$

Lat:  $42^{\circ}14'$ . Computed Sun Bearing: S.  $86^{\circ}05'30''$  W.

Angle Rt. from sun to line:  $4^{\circ}12'30''$ .

