


SURVEY IN THE SW 1/4 SW 1/4 SECTION 33  
T.38 S., R.3 W., W.M., JACKSON COUNTY, ORE.


FOR  
F.W. FOGELQUIST  
  
SCALE 1" = 200'

SURVEY BY  
CHARLES H. HURST  
MEDFORD, OREGON

LEGEND  
● SET 5/8" X 24" IRON PINS  
○ SET 3/4" X 30" IRON PINS

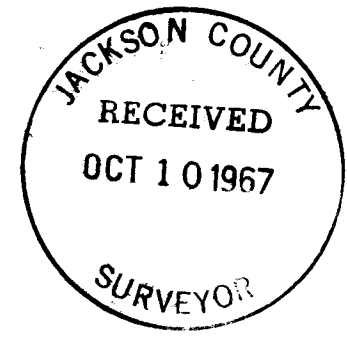

*Charles H. Hurst*

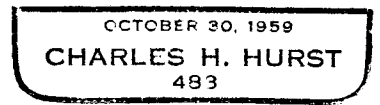

JUL 13 1967

SURVEY NARRATIVE TO COMPLY WITH PARAGRAPH 209.250

OREGON REVISED STATUTES.

Survey for                   Floyd W. Fogelquist  
                                   Route 1, Box 55 E  
                                   Jacksonville, Oregon   97530

Survey by                    Charles H. Hurst, L.S.  
                                   765 Sunrise Avenue  
                                   Medford, Oregon   97501

Purpose                        To separate the tract shown and monument the  
                                   section lines indicated

Bearing                     Based on the meridian of recorded survey #2640

PROCEDURE

All points shown were monumented from random line control previously established.

The south 1/16 corner was monumented with a 3/4"x30" iron pin from which a 12.5" Douglas fir scribed "S1/16 S33 483BT" bears S12 1/4° E 34.33 feet and a 12" Douglas fir scribed "S1/16 S32 483BT" bears N79 1/2° W 19.02 feet. Both witness trees being measured to center.

July 13, 1967

