


FOUND BRASS DISC MARKED.
 S 23, S 24, S 25 & S 26
 T. 39 S. R. 1 E.
 3 B.T.'S VISIBLE

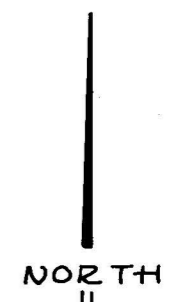

7.02 ACRES

FOUND 1/4 SECTION CORNER.
 BRASS DISC MARKED S 26 | S 25
 T. 39 S. R. 1 E., R.S. 483, 1966

FOUND CW 1/16 CORNER
 3/4" DIA. RE BAR & 2
 B.T.'S VISIBLE.

MAP OF SURVEY
 LOCATED IN
 SW 1/4 OF NW 1/4 OF SECTION 25, T. 39 S. R. 1 E. W.M.
 JACKSON COUNTY OREGON
 FOR
 J. P. CLARK

JACKSON COUNTY
 RECEIVED
 OCT 10 1967
 SURVEYOR

OREGON
 LAND SURVEYOR
Everett L. Swain
 EVERETT SWAIN

EVERETT L. SWAIN REG. L.S. ASHLAND, OREGON
 SCALE 1" = 100' OCT. 6, 1967
 BASIS OF BEARING R/S # 3365
 O SET 5/8" x 30" IRON PINS
 X SET 5/8" x 24" IRON PINS
 ● FOUND MONUMENTS AS SHOWN

3562

3562

Survey Narrative to Comply With Paragraph 209.250
Oregon Revised Statutes
1963


Survey For: J. P. Clark
Ashland, Oregon

Location: Parcel Located in the Southwest One Quarter of
the Northwest One Quarter of Section 25,
Township 39 South, Range 1 East of the
Willamette Base and Meridian, Jackson County,
Oregon.

Purpose: To survey, monument and prepare a legal description
of a parcel of land, as directed by the client.

Procedure: Found the monuments as indicated on recorded
survey No. 3365 and used this for my control.
Recorded Survey No. 3365 was used for the basis
of bearings.

October 6, 1967

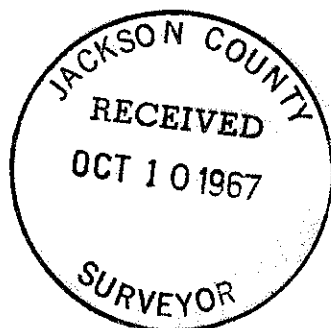

Everett L. Swain
Registered Land Surveyor
Ashland, Oregon

