

3578

8298

Survey For the

CITY OF GOLD HILL

Located in

DEKUM'S AMENDED ADDITION


in the S.E. 1/4 Sec. 16

T.36S.R.3W, W.M.

GOLD HILL, OREGON

By: Mark E. Boyden

Oct., 27, 1967

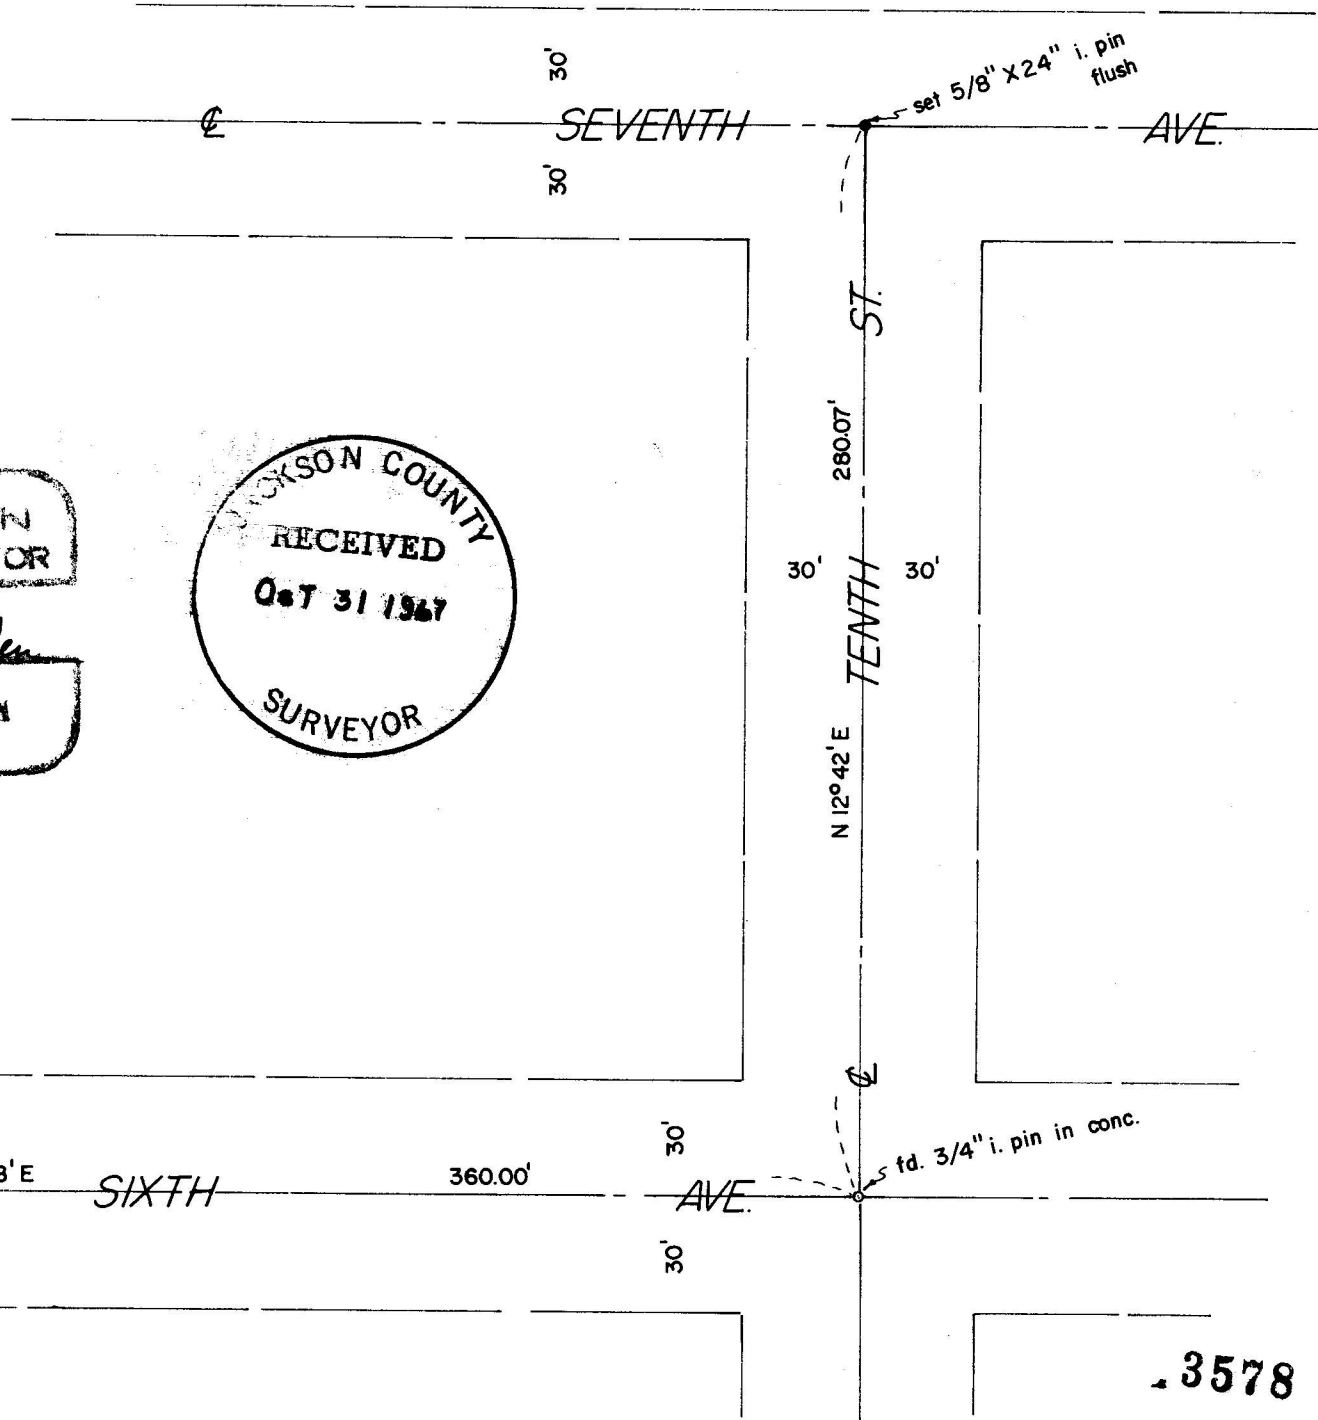

REGISTERED
OREGON
 LAND SURVEYOR
Mark E. Boyden
 NOVEMBER 9, 1961
MARK E. BOYDEN
 281

JACKSON COUNTY
 RECEIVED
 OCT 31 1967
 SURVEYOR



SCALE: 1" = 50'

Basis of Bearings:
 Recorded Survey
 No. 1875

3578

SURVEY NARRATIVE TO COMPLY WITH O.R.S. 209.250

FOR: City of Gold Hill
City Hall
Gold Hill, Oregon

PURPOSE: To monument the centerline intersection of
Seventh Avenue with Tenth Street in DEKUM'S
AMENDED ADDITION to the City of Gold Hill,
Oregon.

PROCEDURE: Found street centers on Sixth Avenue as previously
established by this office on Recorded Survey No. 3458.

Monumented the desired street center at the bearing and
distance previously determined on Recorded Survey No. 2717
and said Recorded Survey No. 3458.

October 27, 1967

