

SURVEY IN SEC 28 T 38S. R. 3 W. WM
 FOR
 RUSSELL MEE
 63-7

BY EDWARD MC GINTY
 MED FORD OREGON
 JULY

SCALE 1"=200'
 5/8" I. PIN FD.
 5/8" I. PIN

JACKSON COUNTY
 RECEIVED
 NOV - 8 1967
 SURVEYOR

1967 REGISTERED
 OREGON
 LAND SURVEYOR


Edward A. McGinty
 JULY 10, 1967
 EDWARD A. MCGINTY
 301

Survey No. 3582


SURVEY NARRATIVE TO COMPLY WITH CHAP. 555, ORS 1963:

Survey for: Russell Mee
Rt. 1 Box 59-A
Jacksonville, Oregon
97530

Survey by: Edward A. McGinty, L.S.
Medford, Oregon
July, 1967

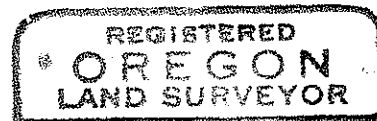

Edward A. McGinty

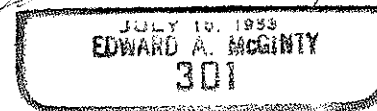

Basis of Bearing; Survey No. 3243.

Precedence of Survey:

Monuments found being 5/8 in. iron pins, approx. flush with the surface. Monuments set, being 5/8 in. iron pins, 20 ins. long, approx. flush with the surface.

Surveyed Tract E, northerly and westerly boundaries and prepared descriptions using previous surveys of record for the easterly and southerly boundaries.

