

REGISTERED
OREGON
 LAND SURVEYOR

Edward A. McGinty
 JULY 10, 1953
EDWARD A. MCGINTY
 301

SURVEY IN NW 1/4 SEC. 32 T37S, R2 W, WM.
 BLK 1 ORIGINAL TOWN OF J-VILLE

FOR
JIM TUCKER

67-26

BY EDWARD MCGINTY
 MEDFORD OREGON
 AUGUST 1967

JACKSON COUNTY
 RECEIVED
 NOV - 8 1967
 SURVEYOR


SCALE 1"=50'
 ● 5/8" PIN SET
 ○ 5/8" PIN FD.

Survey No. 3584


SURVEY NARRATIVE TO COMPLY WITH CHAP. 555, ORS 1963

Survey for: Jim Tucker
2872 So. Pac. Hwy.
Medford, Oregon

Survey by: Edward A. McGinty, L.S.
Medford, Oregon
Sept. 1967

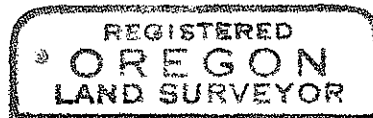

Edward A. McGinty

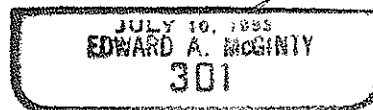

Basis of Bearing: Survey No. 1339.

Precedence of Survey:

Monuments found being 5/8 in. iron pins, set approx. flush with the surface.

At the intersection of Oregon & Calif. St., found 3/4 in. iron pipe, approx. 12 ins. deep.

Surveyed tract of land as shown.

