

(A) DEED REC. VOL. 659, PG. 305  
 (B) DEED REC. OR 67-02183

REGISTERED  
**OREGON**  
 LAND SURVEYOR  
*Charles H. Hurst*  
 LICENSE NO. 1052  
**CHARLES H. HURST**  
 203

SEP 28 1967

PROPOSED R/W WIDTH  
 0+00 - 3+15.22      20 FEET  
 3+15.22 - 27+12.52      6 FEET

**SURVEYOR'S STATEMENT**

CHARLES H. HURST STATES HE IS BY OCCUPATION A SURVEYOR EMPLOYED BY HARRY MC ALLISTER TO MAKE THE SURVEY OF IRRIGATION PIPELINE AS DESCRIBED AND SHOWN ON THIS MAP; THAT THE SURVEY OF SAID WORKS WAS MADE BY HIM AND UNDER AUTHORITY COMMENCING ON THE 26 DAY OF SEPTEMBER, 1967, AND ENDING ON THE 27 DAY OF SEPTEMBER, 1967; AND THAT SUCH SURVEY IS ACCURATELY REPRESENTED UPON THIS MAP.

*Charles H. Hurst*  
 SURVEYOR

**APPLICANT'S CERTIFICATE**

THIS IS TO CERTIFY THAT CHARLES H. HURST WHO SUBSCRIBED THE STATEMENT HEREON IS THE PERSON EMPLOYED BY THE UNDERSIGNED APPLICANT TO PREPARE THIS MAP, WHICH HAS BEEN ADOPTED BY THE APPLICANT AS THE APPROXIMATE FINAL LOCATION OF THE WORKS THEREBY SHOWN; AND THAT THIS MAP IS FILED AS A PART OF THE COMPLETE APPLICATION, AND IN ORDER THAT THE APPLICANT MAY OBTAIN THE BENEFITS OF 43 C.F.R. 22.34 UNDER ACT OF MARCH 3, 1891 (26 STAT. 1101 AS AMENDED); AND I FURTHER CERTIFY THAT THE RIGHT-OF-WAY HEREIN DESCRIBED IS DESIRED FOR AN IRRIGATION PIPE LINE.

ATTEST:  
*Walter Thomas*

*Harry McAllister*  
 APPLICANT

**TRAVERSE DATA**

|    |                 |         |
|----|-----------------|---------|
| 1  | N 72° 30' 45" W | 91.00'  |
| 2  | N 37° 50' 45" W | 70.95'  |
| 3  | S 84° 11' 45" W | 153.27' |
| 4  | N 82° 05' 20" W | 300.75' |
| 5  | N 67° 56' 50" W | 291.40' |
| 6  | N 65° 57' 40" W | 394.34' |
| 7  | N 48° 22' 10" W | 520.00' |
| 8  | N 56° 03' 40" W | 393.45' |
| 9  | N 56° 03' 40" W | 179.73' |
| 10 | N 82° 31' 40" W | 161.79' |
| 11 | N 68° 48' 25" W | 215.64' |

PIPELINE SURVEY IN SECTION 3  
 (NE 1/4 NE 1/4, NE 1/4 NW 1/4, W 1/2 NE 1/4)  
 T. 39 S., R. 3 W., WILL. MER.  
 JACKSON COUNTY, OREGON

FOR  
 HARRY MC ALLISTER

SCALE 1" = 400'

SURVEY BY:  
 CHARLES H. HURST  
 MEDFORD, OREGON

LEGEND  
 ● SET 5/8" X 24" IRON PINS

JACKSON COUNTY  
 RECEIVED  
 DEC 18 1967  
 SURVEYOR

SURVEY NARRATIVE TO COMPLY WITH PARAGRAPH 209.250  
OREGON REVISED STATUTES

SURVEY FOR: Harry McAllister  
Route 1, Box 46C  
Jacksonville, Oregon

SURVEY BY : Charles H. Hurst, L.S.  
28 No. Oakdale  
Medford, Oregon


BEARING : Based on meridian established by solar observation  
Sept. 27, 1967.

PURPOSE : To establish the center line for an irrigation pipe  
line right-of-way across Federal land as shown on  
the attached plat.


PROCEDURE

From a spring located on the south side of Spencer Creek, the center line was monumented along a location approved by the client to a point of termination designated 27+12.52.

From station 24+96.88, a 5/8" iron pin bears South 58°41'55" East 45.22 feet. From station 27+12.52, a 5/8" iron pin bears South 18°50'20" East 24.50 feet, said pins set as shown by Recorded Survey #1607.

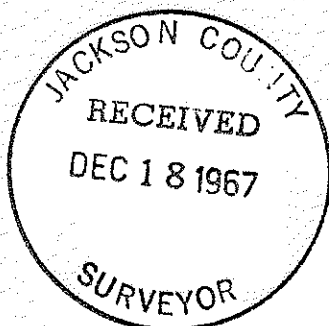

*Charles H. Hurst*

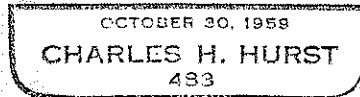

OCT 10 1967