

January 4, 1968

County Surveyor
Jackson County Courthouse
Medford, Oregon

Dear Sir:

Reference is made to the quarter corner common to Sections 28 and 29, Township 37 South, Range 1 East of the Willamette Meridian, Jackson County, Oregon.

This corner has been found and perpetuated as follows: I found a rosette of stones set flush with the ground at the center of which I set a brass capped 1"x30" iron pipe for corner from which an original bearing tree, now a down oak snag with butt scribe plainly visible, bears S30°E (Gov't. record S36°E) 36.30 feet to edge of stump hole and the edge of a pine stump hole bears N63°W 24.42 feet. Cap is marked: T37S R1E

$\frac{1}{4}$
S29 + S28

RS483 1968

I scribed a 14" Douglas fir "1/4S28 483 BT" which bears N66 $\frac{1}{2}$ °E 19.6 feet; a 12" Douglas fir "S29 483BT" which bears S7 $\frac{1}{2}$ °W 33.2 feet. The corner location falls about 550 feet East of an old cabin and 260 feet South of a spring branch.


The perpetuation of this corner was witnessed by Mr. George G. Moore, 465 Sheridan, Ashland, Oregon.

Trees measured to face.

Sincerely,



Charles H. Hurst

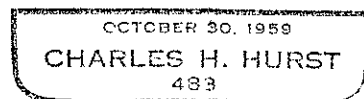

cc: Geo. G. Moore

