

SURVEY FOR TOM WHITTLE

Sec. 28, T.37 S., R.1 W., W.M.

Jackson County, Oregon

December 6, 1967

3618

COUNTRY CLUB MANOR
SUBDIVISION

PLACE

WALDEN

N 36° 45' 40" E

101.00

22.20

141.33

Recorded Survey

No. 3550

SCALE: 1" = 30'




N 24° 48' 44" W

19.00

N 55° 55' 14" E

101.00

N 36° 45' 40" E

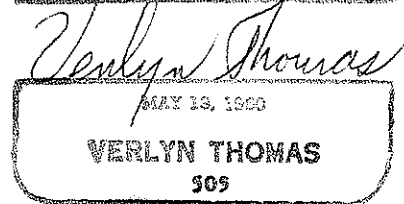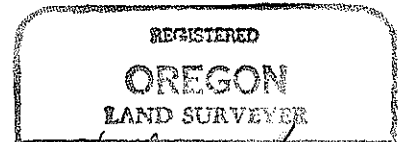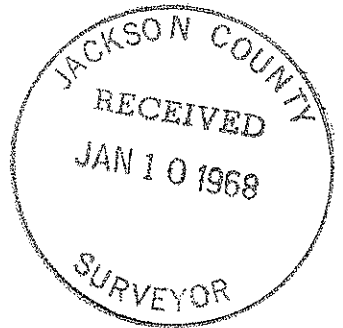

LEGEND

- 5/8" I.Pin found
- 5/8" I.Pin set

Verlyn Thomas, Professional Land Surveyor, Medford, Oregon.

3618

SURVEY NARRATIVE TO COMPLY WITH O.R.S. 209.250
REVISED BY CHAPTER 555, O.L. 1963

FOR: Tom Whittle
406 West Main St.
Medford, Oregon

PURPOSE: To set two property pins as requested by client.

PROCEDURE: Recovered monuments previously set in Recorded Survey No.
3550, and set two additional pins as shown on the accompanying
Plat.

