

SURVEY FOR HUTCHINS & CLARKE
KENSINGTON SQUARE SUBDIVISION



City of Medford
Jackson County, Oregon

December 7, 1967


4792-3619

LEGEND

- Mon. found
- Mon. set

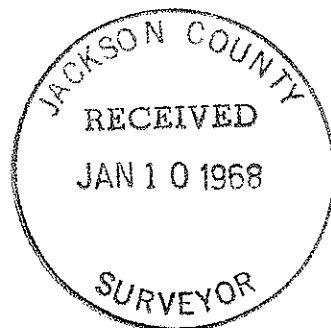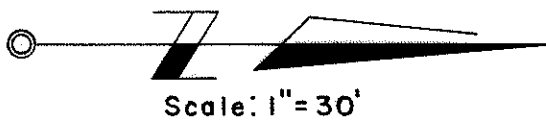

KENSINGTON SQUARE

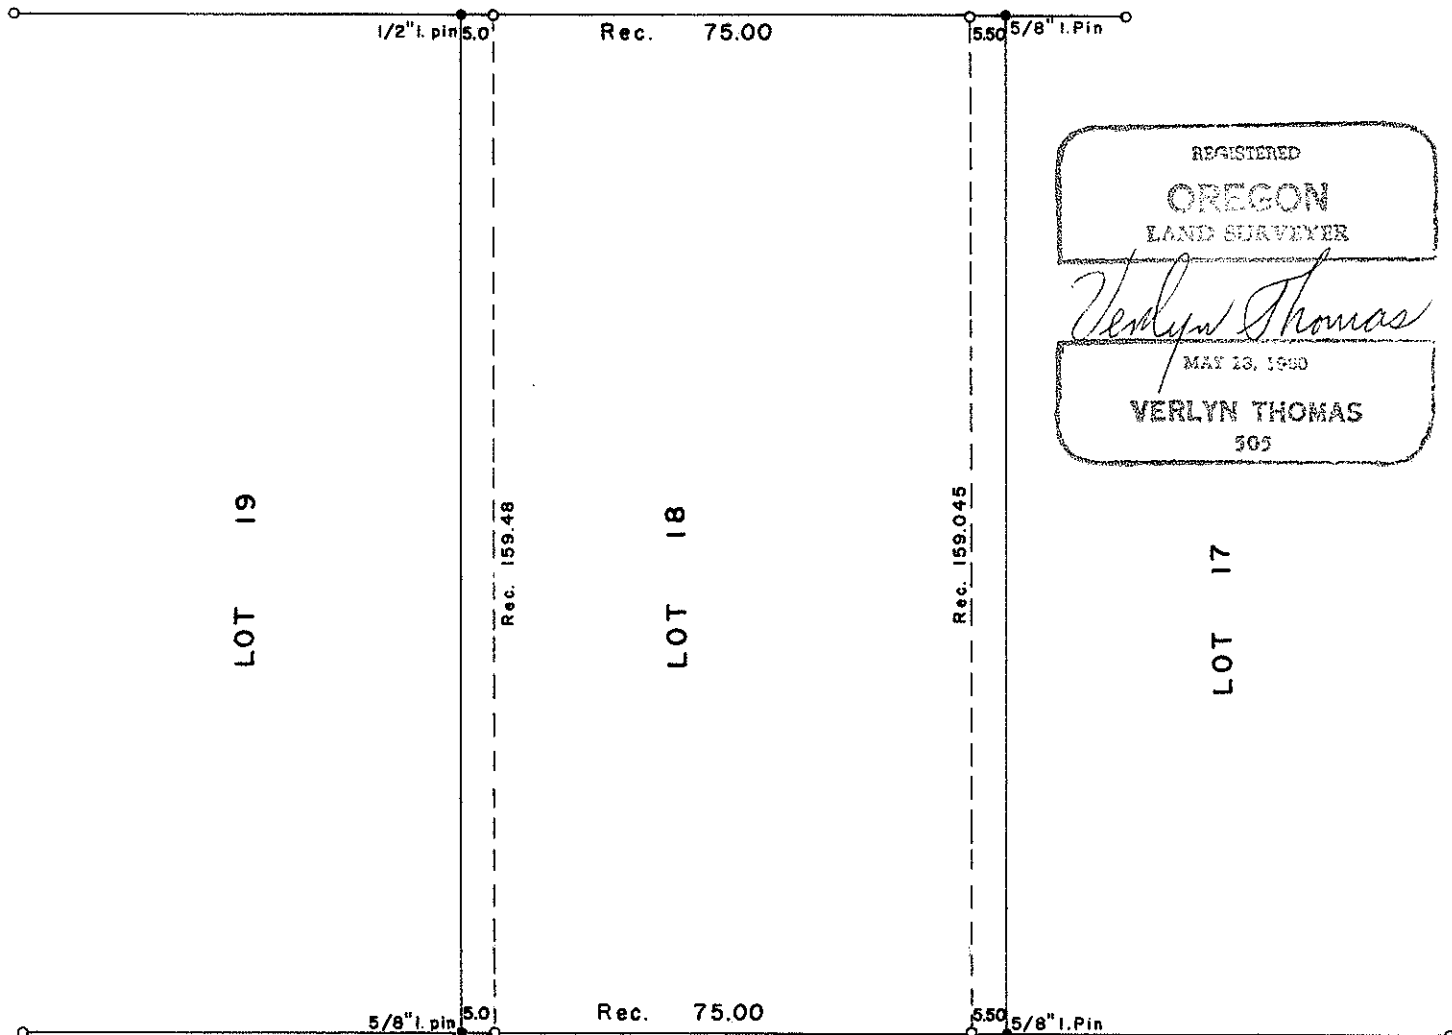

SURVEY NARRATIVE TO COMPLY WITH O.R.S. 209.250
REVISED BY CHAPTER 555, O.L. 1963.

FOR: Hutchins & Clarke Construction Co.
3486 Britt Ave.
Medford, Oregon

PURPOSE: To survey and monument a parcel according to City of Medford requirements for residence under construction.

PROCEDURE: Recovered original Lot corners as shown on the accompanying Plat. Surveyed and monumented the South 5.50 feet of Lot 17, and the North 5.00 feet of Lot 19, KENSINGTON SQUARE SUBDIVISION in the City of Medford, Jackson County, Oregon.

