

SURVEY IN NE 1/4 SEC. 32 T.37S. R.2W. W.M.
 FOR
 CITY OF JACKSONVILLE

BY EDWARD MCGINTY
 MEDFORD OREGON
 MARCH 1967

67-30
 SCALE 1"=100'
 ○ = 5/8" I.PIN
 ● = 3/4" REBAR
 □ = R.R. SPIKE

REGISTERED
 OREGON
 LAND SURVEYOR

Edward A. McGinty

JULY 10, 1953
 EDWARD A. MCGINTY
 301

JACKSON COUNTY
 RECEIVED
 JAN 26 1968
 SURVEYOR

3632


3632

Survey No. 3632


Survey Narrative to comply with Chap. 555, OL 1963.

Survey for: City of Jacksonville
Jacksonville, Oregon

Survey by: Edward A. McGinty, L.S.
Medford, Oregon

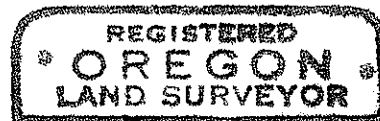

Edward A. McGinty

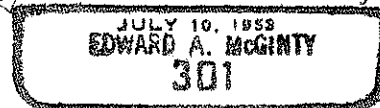

Basis of Bearing: Survey No. 1339.

Monumented streets as shown, at request of the City of Jacksonville.

Center line of 5th Street being the City center line, as previously determined. Hueners Lane determined from previous survey and monuments found and plat of record.

G Street and Park Street were determined from Deed Records, plat and improvements.

Blackstone Alley and Academy St. from previous surveys and Deed Records and improvements along Academy.

Monuments of 5th Street, set flush

Blackstone & Academy, 5/8" x 24" iron pins, 6 ins. deep

Blackstone and E Street, " "

6th Street and E Street " "

Park St. and G Street " "

Center line angle point in Park St.

Center line angle point in Hueners Lane

Railroad spike center line of Park St. approx. 6 ins. deep.

Other monuments set being 5/8 in. X 24 in. iron pins, set approx. flush with the surface.

