


T. 35 S. 31 32 R. 1 E., W.M.
T. 36 S.

NOTE: FOUND RE-ESTABLISHED WITNESS TREES TO N.E. & S.E. AND FOUND IRON BOLT N 0° 03' W 1000' FROM TRUE CORNER.

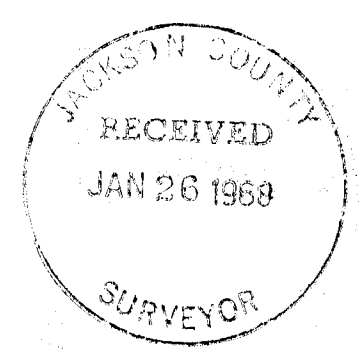

REG. L.S.
J. A. HOFFBUHR
J. A. HOFFBUHR

MAP OF SURVEY
LOCATED IN
S.E. 1/4 SEC. 31 AND THE S.W. 1/4 SEC. 32, T. 35 S., R. 1 E., W.M.
JACKSON COUNTY OREGON
FOR
DONALD BIEBERSTEDT
J. A. HOFFBUHR, REG. L.S., MEDFORD, OREGON
SCALE, 1"=100' JANUARY 19, 1966
BASIS OF BEARING- R/S NO. 1429
° SET 5/8" X 24" STEEL REINF PIN

Survey Narrative To Comply With Paragraph 209.250
Oregon Revised Statutes

SURVEY FOR: Donald Bieberstedt
265 Royal Avenue South
Eagle Point, Oregon

LOCATION: Tract situated in Section 31, Township 35 South,
Range 1 East, Willamette Meridian, Jackson
County, Oregon.

PURPOSE: To monument and describe the boundaries of the
tract indicated on the attached map, also to
monument and describe the dividing line between
the tracts described in Volume 169, Page 28 and
the Deed filed as No. 66-01314 of the Official
Records of Jackson County as now existing. The
client to use the description of the boundary
line, as shown, to establish the line of record
by boundary line agreements between the parties
involved.

The client did not want to subdivide the Section
to determine the true East Line of the Northwest
Quarter (1/4) of the Southwest Quarter (1/4) of
Section 32, therefor, a witness corner was set
to the line. Basis of bearings--Recorded Survey
No. 1429.

January 23, 1968

J. A. Hoffbuhr
Registered Land Surveyor

