

S.E. COR. D.L.C. NO. 50  
FOUND 1" PIPE  
W/BRONZE DISC

FOUND 5/8" IRON BOLT  
IN CONCRETE

# PARK TERRACE SUB.

LOT 1    LOT 2

LOT 5

PARKDALE DR.

FOUND 5/8" IRON PIN

FOUND 1 1/2" GALV. IRON PIPE  
INSIDE ELL. COR. D.L.C. NO. 51

3673

RE: R/S NO. 2415

N0° 12' 30" W 662.40' (REC. 662.30')

S89° 57' 20" E (REC. N89° 56' E) 965.735'

S 89° 57' 20" E

FOUND 5/8" IRON PIN

19.6 AC. ±

8.4 AC. ±

FOUND 1" PIPE W/BRONZ DISC  
N.E. COR. D.L.C. NO. 46

N0° 05' 30" W  
89.86'

N.E. 1/4, SEC. 32

S.E. 1/4, SEC. 32

FOUND BRASS DISC  
IN CONG.

140'

INTERSTATE HWY. 5

N39° 45' 40" W 978.01'  
750.08'

1508.30'

S0° 12' 30" E

N89° 55' 55" W (REC. WEST)  
337.89'



FOUND 5/8" IRON PIN

HWY. STA. 909+00 RQT.

140'

N46° 51' 09" W  
72.24'

S89° 55' 55" E  
34.145'

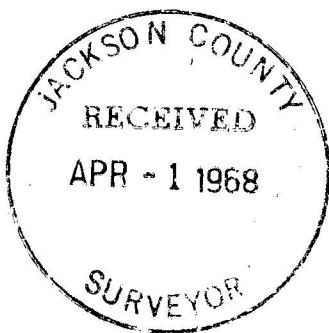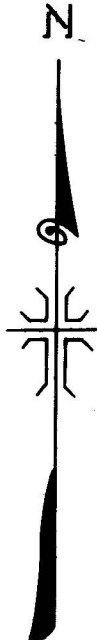

REGISTERED  
REGON  
SURVEYOR

*J. A. Hoffbuhr*

EXPIRES FEB 7 1947

J. A. HOFFBUHR  
222

MAP OF SURVEY  
LOCATED IN  
EAST 1/2 OF SECTION 32, T. 37 S., R. 1 W., W.M.  
JACKSON COUNTY OREGON  
FOR  
ELKS LODGE B.P.O.E. NO. 1168

J. A. HOFFBUHR, REG. L.S., MEDFORD, OREGON  
SCALE: 1"=200'                      FEB. 24, 1968  
BASIS OF BEARING -                      R/S NO. 2415  
o=SET 5/8" X 24" IRON REINFORCING PIN

3673

Survey Narrative To Comply With Paragraph 209.250  
Oregon Revised Statutes

SURVEY FOR: Elks Lodge B.P.O.E. No. 1168  
North Central & 5th Street  
Medford, Oregon 97501

LOCATION: Tract situated in the East One Half (1/2)  
of Section 32, Township 37 South, Range  
1 West, Willamette Meridian in Jackson  
County, Oregon.

PURPOSE: To monument and describe the boundaries of  
the tract as shown on the attached map.

PROCEDURE: The Donation Land Claim Corners were found  
for control. The control of the centerline of Interstate Highway  
No. 5 was also found and used as indicated. Basis of bearings--  
Recorded Survey No. 2415.

March 26, 1968

J. A. Hoffbuhr  
Registered Land Surveyor

