


3690

0698

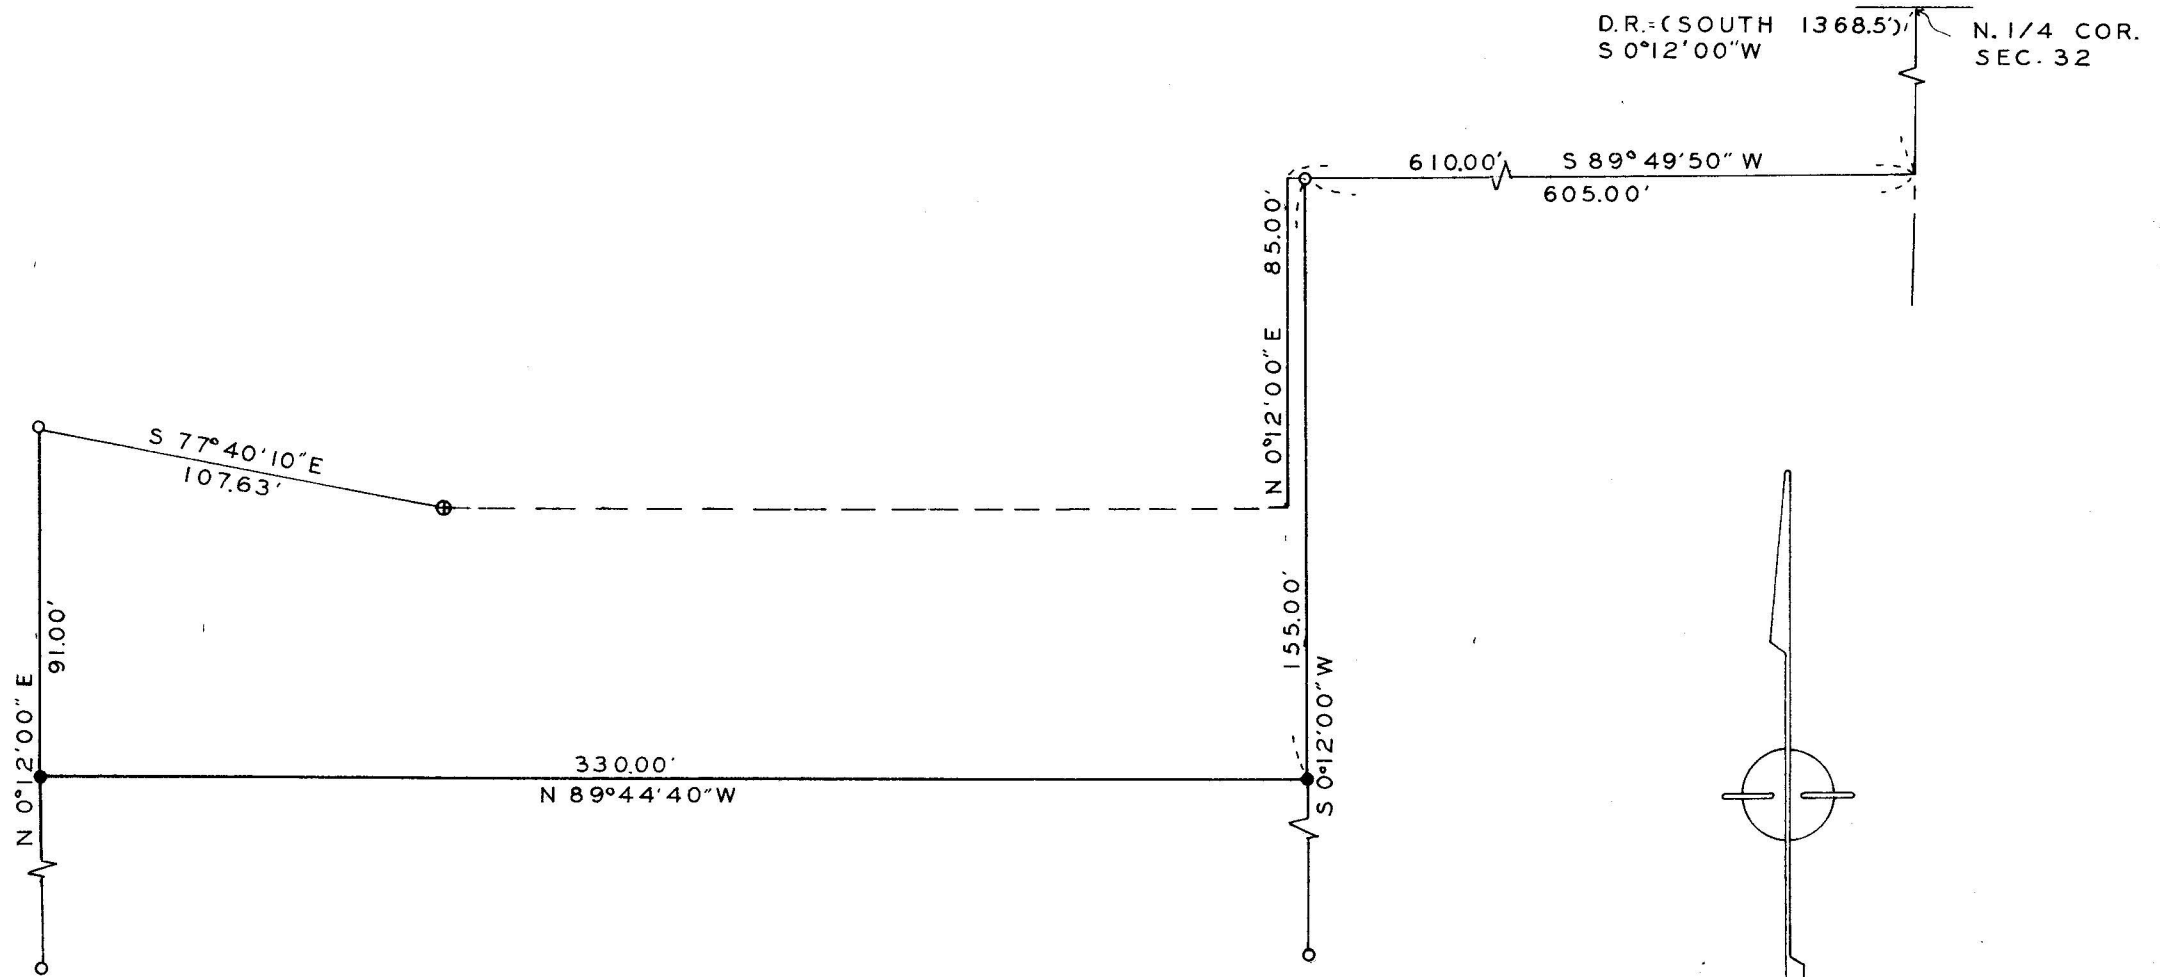

SURVEY IN N.W. 1/4 SEC. 32 T.35S. R.1W. W.M.
FOR




CARLTON BARKHURST

68-5

EDWARD MCGINTY
MEDFORD OREGON
JANUARY 1968

SCALE 1"=50'

- = 5/8" I.PIN SET
- = 5/8" I.PIN FD.
- ⊕ = 3/4" I.PIPE FD.

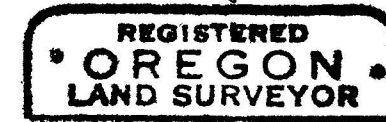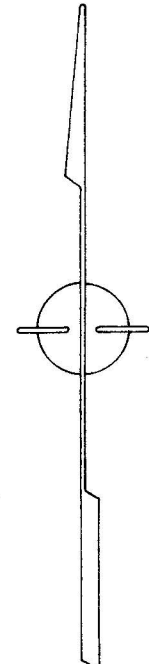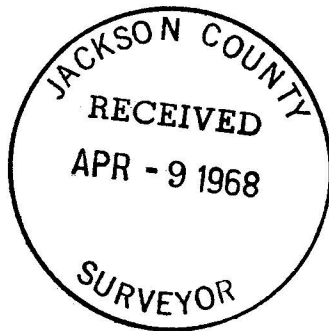

Edward A. McGinty



3690

Survey No. 3690

Survey Narrative to comply with Chap. 555, O.L. 1963.

Survey for: Mr. Carlton Barkhurst
Agate Rd.
White City, Oregon

Survey by: Edward A. McGinty, L.S.
Medford, Oregon
Feb. 1968

Basis of Bearing: Survey No. 3434.

Precedence of Survey:

This survey is a partial retracement of previous surveys No. 3434 and No. 3587.

Found a 5/8 in. iron pin, approx. flush with the surface and set a 5/8 in. x 24 in. pin approx. flush with the surface. Prepared a description from the surveyed line.

