


3702 3702

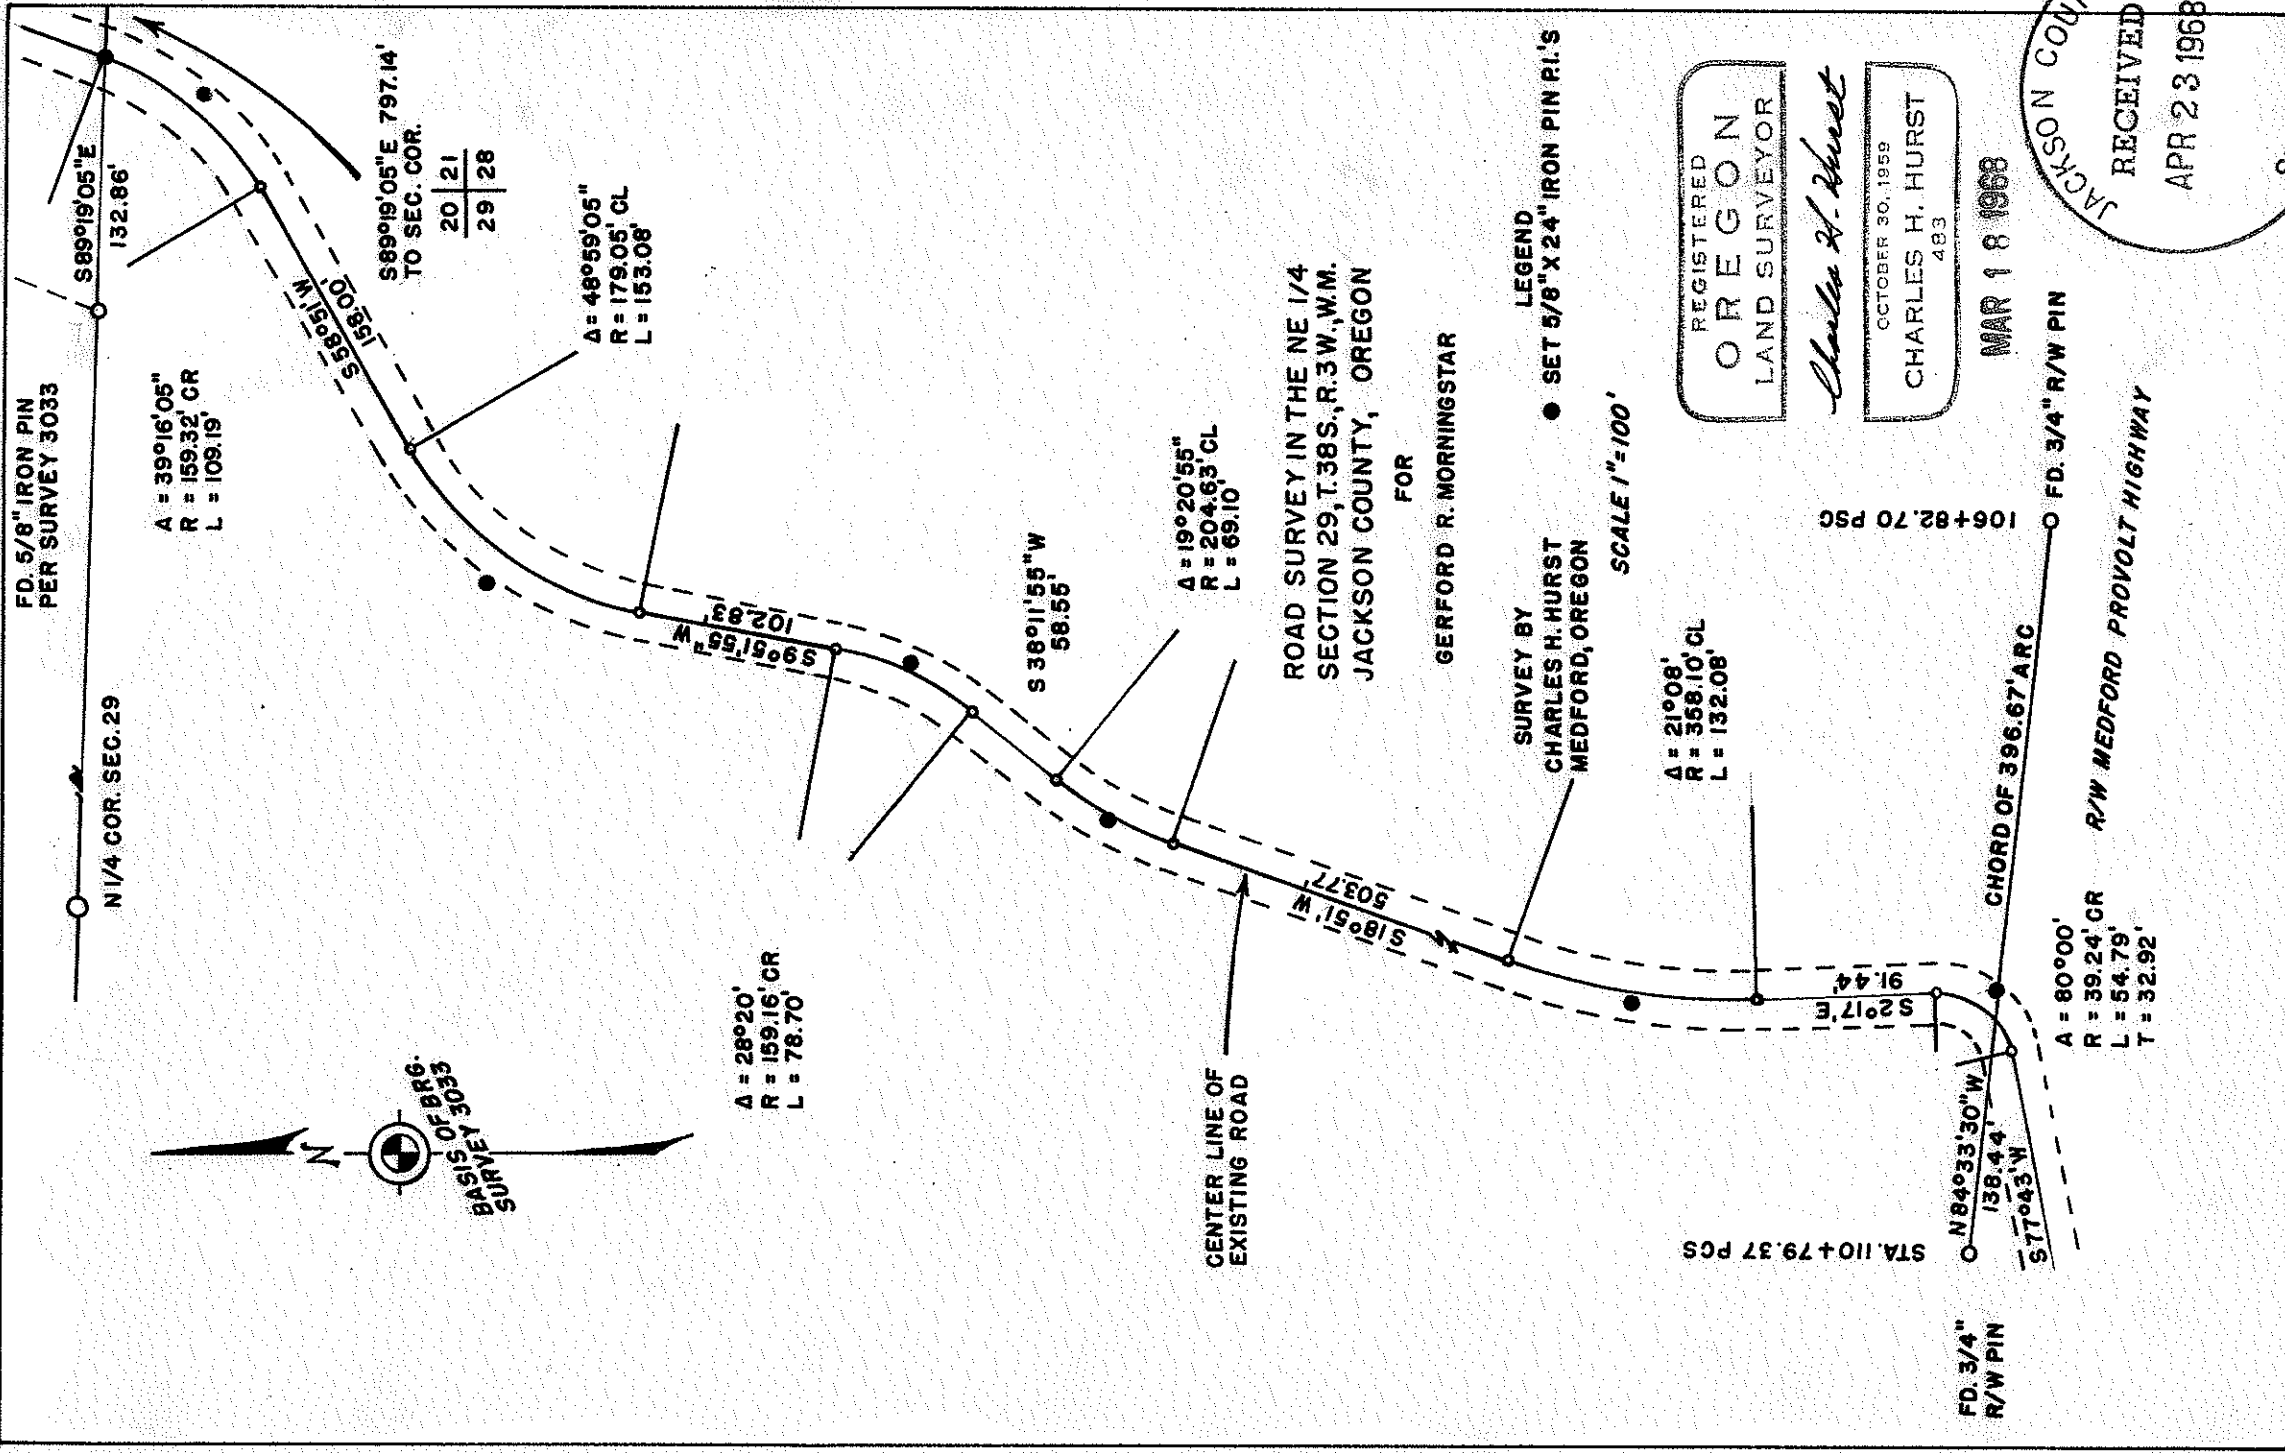

3702

Survey for: Gerford R. Morningstar  
 305 Wetzel Way  
 Yreka, California 96097

Survey by: Charles H. Hurst, L.S.  
 28 North Oakdale  
 Medford, Oregon 97501



Bearing: Based on meridian of Recorded Survey No. 3033

Purpose: To define and monument an existing road for location and descriptive purposes.

PROCEDURE

The center line was monumented at P.I.'s. only. The easterly boundary of said road coincides with an existing fence line. Said road has reportedly been in use for years providing access to lands lying north of Section 29.

Date: March 18, 1968

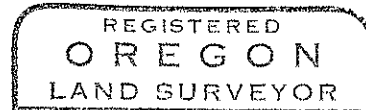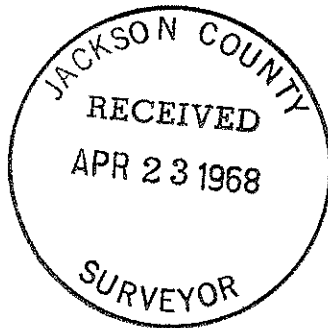

*Charles H. Hurst*

