

SURVEY IN SEC. 20 T.34 S. R.1 W., W.M.

FOR  
ALEXIS BOUTACOFF

61-18

BY EDWARD MCGINTY  
MEDFORD OREGON  
MAY 1968

SCALE 1"=500'  
● = 5/8" I.PIN SET  
○ = 1" I.P.I.PE FD.

REGISTERED  
OREGON  
LAND SURVEYOR

*Edward A. McGinty*  
JULY 10, 1953  
EDWARD A. MCGINTY  
301

JACKSON COUNTY  
RECORDED  
JUN 17 1968  
SURVEYOR

3736

.3736

Survey Narrative to Comply with O.R.S. 209-250.

Survey for: Mr. A. Boutacoff  
2525 El Camino Real  
Redwood City, Calif.

Survey by: Edward A. McGinty, R.S.  
Medford, Oregon  
May, 1968

Basis of Bearing: Solar Observation



Precedence of Survey:

Sub-divided Section 20:

A. SOUTHWEST CORNER OF SECTION 20: Found rock mound and an old post.  
Set a 5/8 in. iron pin, 24 ins. long, approx. flush with the surface, from which

- Orig. BT. white oak, now 18 in. diam., bears S. 47 1/2° E., 68.6 ft.
- A down pine snag, BT visible, bears S. 85 1/4° W., 67.2 ft.
- Orig. BT. white oak, now 16 ins. diam. rotten inside, bears N. 17 3/4° W. 63.1 ft.
- Orig. BT. white oak, now 16 ins. diam., rotten inside, bears N. 33° E., 69.6 ft.

NEW TREE


White oak, 5 ins. diam., bears S. 75 3/4° W., 22.0 ft.,  
2 blazes.

B. WEST 1/4 CORNER - Set 5/8 x 24 in. iron pin, 12 ins. high in a mound of stone, from which

- Ashes of orig. black oak, BT bears N. 23° 00' E., 28.4 ft.  
note, portion of remains of snags near by.
- center of black oak sprouts, from which orig. BT bears S. 17° 00' W., 26.4 ft.

NEW TREES DOUBLE BLAZED

- Madrone, 8 ins. diam., bears N. 84° E., 7.5 ft.
- Fir, 6 ins. diam., bears N. 46 1/2° W., 30.3 ft.

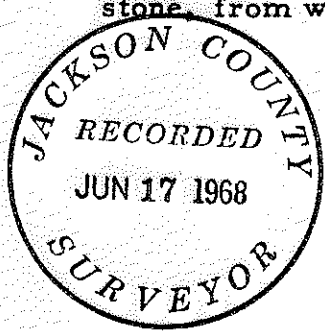

- C. NORTHWEST CORNER OF SECTION 20: found 1 in. iron pipe with expander 1 1/2 top filled with lead, set by county surveyor.
- D. NORTH 1/4 CORNER found a 1 in. iron pipe, 3 ins. high, in rock mound.
- E. EAST 1/4 CORNER - found 1 in. pipe.
- F. SOUTHEAST CORNER OF SECTION 20 - found 2 in. pipe, approx. flush, set by county surveyor.
- G & H. See survey for Boutacoff in Sections 29.

Monuments set being 5/8 in. x 24 in. iron pins, set approx. flush with the surface.