

SURVEY IN S. 1/2, SEC. 5 T.35S. R.1W, W.M.

FOR  
ALEXIS BOUTACOFF  
68-10

BY EDWARD MCGINTY  
MEDFORD OREGON  
MARCH 1968

SCALE 1"=100'  
• = 5/8" I. PIN SET  
•• = 1/2" I. PIN FD.  
○ = 3/4" I. PIPE FD.

REGISTERED  
OREGON  
LAND SURVEYOR  
*Edward A. McGinty*  
JULY 10, 1953  
EDWARD A. MCGINTY  
301

JACKSON COUNTY  
RECORDED  
JUN 17 1968  
SURVEYOR

Survey No. 3744

Survey Narrative to comply with O.R.S. Chap 555, Revised 1963.

Survey for: Mr. A. A. Boutacoff  
P.O. Box 1280  
Redwood City, Calif  
94064

Survey by: Edward A. McGinty, R.S.  
Medford, Oregon  
March, 1968

Basis of Bearing: Solar Observation.

Precedence of Survey:

Monuments:

- A. SW. cor. of Sec. 5, found 2 in. iron pipe, flush with surface.
- B. South 1/4 cor. found 1 in. pipe with brass disc. 8 in. above the ground
- C. Found a 3/4 in. iron pipe, approx. flush with the surface.
- D. Found a 2" x 2" county rd. hub, set 5/8 in. iron pin, flush with the surface.
- E. Found a 5/8 in. iron pin with a hub along side
- F. Found a 1/2 in. iron pipe, 10 ins. deep, See Surv. No. 1590.
- G. Found a 1 in. iron pipe and brass cap at the N. 1/4 cor. and fence cor.
- H. Found a 1/2 in. iron pin, this was replaced with a 5/8 in. x 24 in. iron pin, set flush with the surface.
- I. Found a 1/2 in. iron pin, Sur. No. 1590.
- J. Found 1/2 in. iron pipe.
- K. Found a 1/2 in. iron pipe, 12 ins. deep.

Survey No. 1590 created a division line along the north line of survey and monuments were recovered, since said monuments would control, a retracement was made showing new measurements.


In as much as the south line of said survey or the north line of Survey No. 1110 the intent may be questionable, a proposed boundary line agreement was recommended to the new line as surveyed.

Found that the previous surveys mentioned, with substantial agreement of bearings of deed records, it appears to be in conflict on this survey.

REGISTERED  
OREGON  
LAND SURVEYOR

*Edward A. McGinty*

JULY 10, 1903  
EDWARD A. MCGINTY  
301

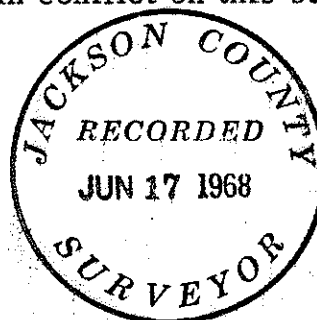

68-10