

Survey For Benton Smith
 Sec. 29, T. 37 S., R. 2., W. M.
 Jacksonville, Oregon
 MAY 9, 1968

N.E. Cor. Lot 14
 Valley View Sub.

LEGEND

- 5/8" I. Pin found.
- 5/8" X 24" I. Pin set.

Basis of Bearing: Survey No. 2217.

N.W. Cor.
 D.L.C. 37


S 00° 12' 0" E
 396.37 (Survey 2217)

SURVEY NO. 2217

87.19 S 70° 00' 35" E (Survey 2217) 85.00

GROVE STREET

60.24

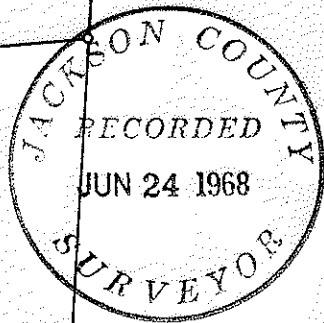

S 21° 44' 30" W
 119.87

N 67° 42' 40" W 166.20

O.R. 68-01246

S 25° 08' 10" W
 115.00

REGISTERED
 OREGON
 LAND SURVEYOR

Verlyn Thomas
 MAY 13, 1960
 VERLYN THOMAS
 505

120.00

N 67° 42' 40" 159.10

Scale: 1" = 40'

3761

3761

SURVEY NARRATIVE TO COMPLY WITH O.R.S. 209.250
REVISED BY CHAPTER 555, O.L. 1965

FOR: - Benton Smith
P.O. Box 502
Medford, Oregon

PURPOSE: To Survey and monument a metes and bounds parcel, according to legal description furnished.

PROCEDURE: Recovered $\frac{5}{8}$ " iron pins set in Recorded Survey No. 2217 for use as control, as shown on the accompanying Plat. Monumented parcel as indicated.

