

SCALE 1" = 100'

BASIS OF BEARINGS RECORDED
SURVEY NO. 3627

LEGEND

○ AS NOTED

SURVEY

FOR


GEORGE METZ ASHLAND, ORE.

OF TRACT

SITUATE IN LOT II, BLOCK "J" OF THE ROGUE RIVER VALLEY ORCHARD CO. TRACTS IN THE S 1/2 SEC 30 T38S R 1 E W.M.

GEORGE BURRELL L.S. ASHLAND, ORE.

JULY 7, 1968

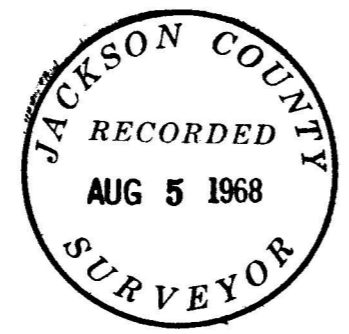

REGISTERED
OREGON
LAND SURVEYOR

George R. Burrell

JULY 10, 1964
GEORGE R. BURRELL
638



SURVEY NARRATIVE TO COMPLY WITH O.R.S. 205.250

REVISED BY CHAPTER 555, O.L., 1963

FOR: George L. Metz
950 Valley View Road
Asbland, Oregon

PURPOSE: To monument and describe that portion of
Lot 11, Block "J", as shown on the accom-
panying map.

PROCEDURE: Established West Boundary Line from County
Centerline Road monuments. The remaining
controlling corner monuments found were set
in 1945 by L. E. Ager, Surveyor for the
tract described in Volume 261, Page 210,
Deed Records, Jackson County, Oregon.

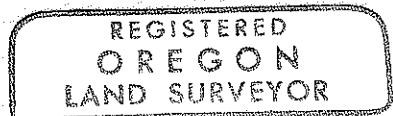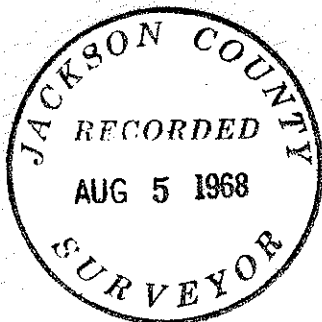

George R. Burrell

