

NORTH

SCALE 1"=20'  
BASIS OF BEARINGS  
DEED RECORD

LEGEND

- SET 5/8" I. PIN
- AS NOTED

# SURVEY

FOR

JIM BUSH ASHLAND, ORE  
OF TRACT

SITUATE IN LOT 13 M<sup>c</sup>CALLS ADDN  
TO THE CITY OF ASHLAND, ORE  
IN THE SW 1/4 N.E. 1/4 SEC 9 T39S R1E  
GEORGE BURRELL L. S. ASHLAND, ORE  
AUG 27, 1968

REGISTERED  
OREGON  
LAND SURVEYOR

*George R Burrell*

JULY 10, 1964  
GEORGE R. BURRELL  
638


JOHNSON COUNTY  
RECORDED  
SEP 23 1968  
SURVEYOR

SURVEY NARRATIVE TO COMPLY WITH O.R.S. 209.250  
REVISED BY CHAPTER 555, O.L. 1963

FOR: Jim Bush  
555 Siskiyou Blvd.  
Ashland, Oregon

PURPOSE: To monument the Westerly line of the tract com-  
positly described and presently encompassed in  
Tax Lot 14600 as shown on map 391E 9AC of the  
Jackson County Assessors Office.

PROCEDURE: Using the monuments found on the Northerly line  
of Siskiyou Blvd. as control, I established said  
Westerly Boundary according to deed record. No  
justification was found for proportional measure-  
ments.

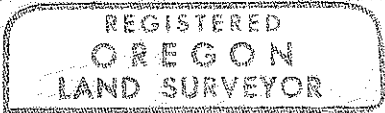

*George Burrell*

