
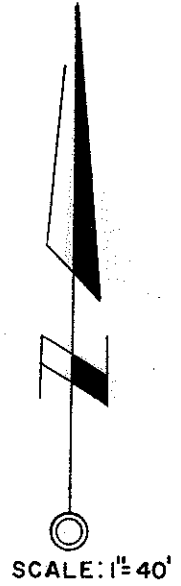


SURVEY FOR RICHARD BROWN
 RESUBDIVISION OF BLOCKS 1, 3, & 4
 BEL AIR HEIGHTS
 Sec. 27, T. 37.S., R. 1.W., W.M.
 July 3, 1968

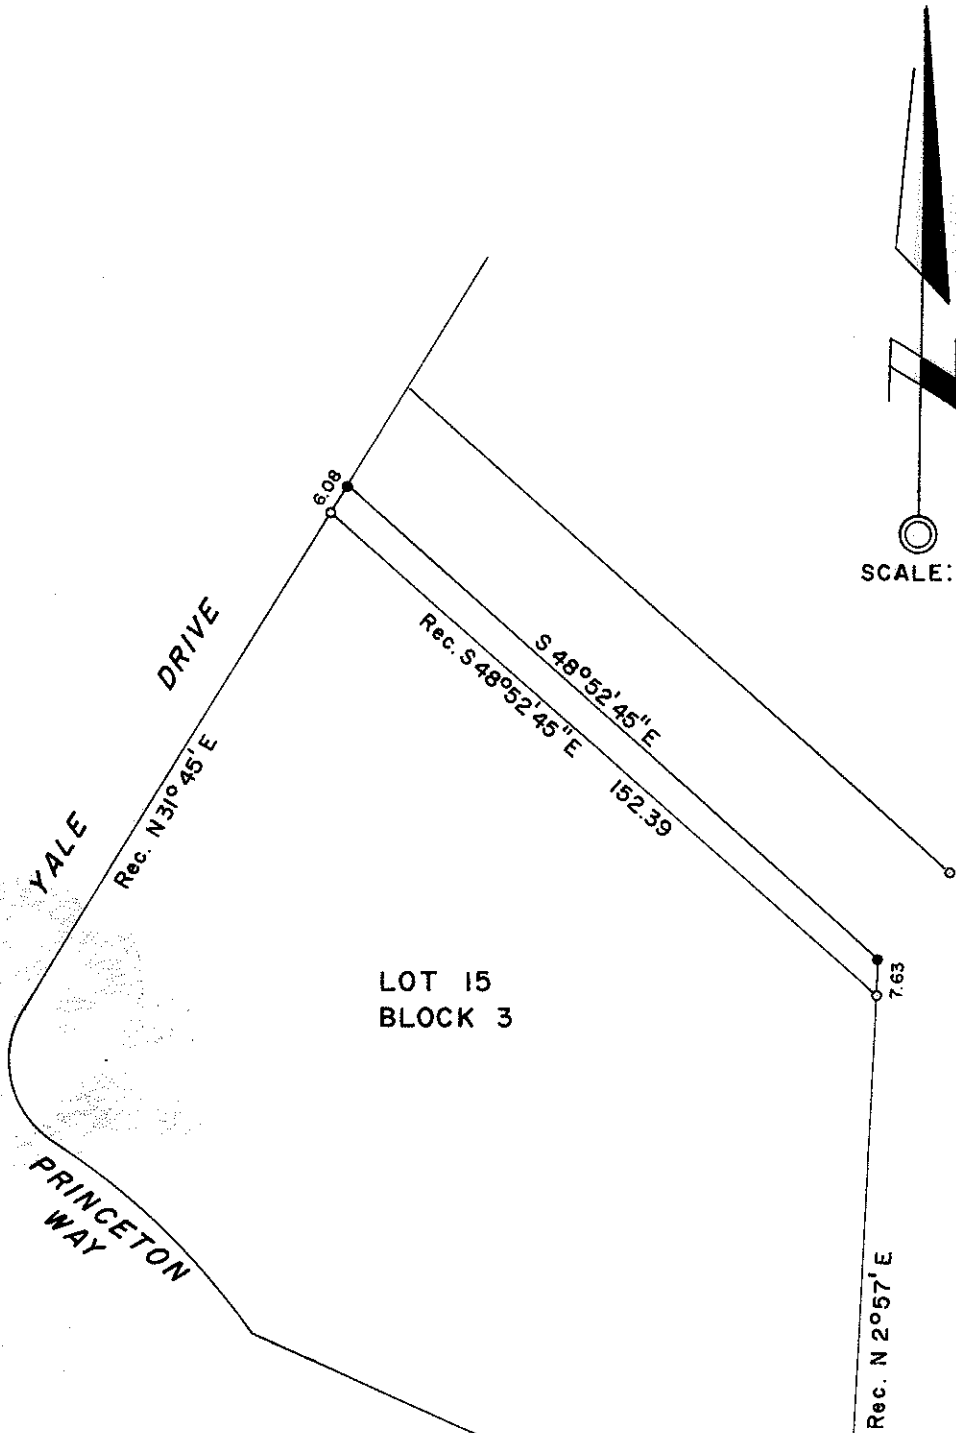

LEGEND

- 5/8" X 24" I. Pin set.
- 5/8" I. Pin found.

REGISTERED
 OREGON
 LAND SURVEYOR

Verlyn Thomas

MAY 13, 1950
 VERLYN THOMAS
 505

JACKSON COUNTY
 RECORDED
 SEP 30 1968
 SURVEYOR

SURVEY NARRATIVE TO COMPLY WITH O.R.S. 209.250
REVISED BY CHAPTER 555, O.L. 1963

FOR: Mr. Richard Brown
255 Yale Drive
Medford, Oregon

PURPOSE: To monument a strip in the "flag" of flag-lot 16 in Block 3 of
THE RESUBDIVISION OF BLOCKS 1,3, and 4, BEL AIR HEIGHTS

PROCEDURE: Recovered original lot corners, and set $\frac{5}{8}$ " iron pins as indicated
on the accompanying Plat.

