


Meridian Record bearing from Sur. No. 1508 R.S. 439

- \bullet = 3/4" 1. Pipes found per Sur. 1508 by R.S. 439
- \circ = 1/2" 1. Rods Set

PLAT

of
 Survey in the SE 1/4 of Sec. 20,
 T. 36 S., R. 4 W., W. M., Jackson
 County, Oregon
 Oct. 18, 1968 Scale 1" = 100'

For:
 MRS. DARYLE HOLT
 215 Fielder Lane
 Rogue River, Oregon

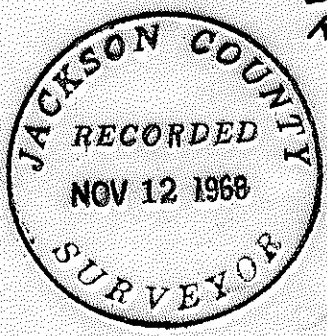

REGISTERED
 OREGON
 LAND SURVEYOR

Claude E. Masters
 OCTOBER 24, 1958
 CLAUDE E. MASTERS
 457

SURVEY NO. 3866

SURVEY NARRATIVE to comply with Paragraph 209.250, Oregon Revised Statutes.

SURVEY FOR: MRS. DARYLE HOLT
215 Fielder Lane
Rogue River, Oregon 97537

PURPOSE: To survey and monument a parcel of land in the Southeast 1/4 of Section 20, Township 36 South, Range 4 West, Jackson County, Oregon.

PROCEDURE: Found 3/4 inch Iron Pipes set in Survey No. 1508 by R.S. 439 and identified by owners as being the identical monuments set in said survey.

Ran line along the Southerly right-of-way line of the Southern Pacific Railroad and set monuments as shown on plat.

Retraced survey on the Northerly bank of Rogue River and set monuments as shown on plat.

Monuments on West line of property were set as instructed by owner.

REGISTERED
OREGON
LAND SURVEYOR

Claude E. Masters

OCTOBER 24, 1958
CLAUDE E. MASTERS
457

