


SCALE 1"=20'
BEARING DATUM: PLAT RECORD

- LEGEND
- SET 5/8" I. PIN
 - AS NOTED

SURVEY

FOR
E. S. MORGAN SAN MATEO, CALIF
OF TRACT
SITUATE IN LOTS 32 AND 33 HUNSAKERS ADDN.
TO THE CITY OF ASHLAND, ORE. IN S.W. 1/4 NE. 1/4
SEC 9 TWP 39S R1EWM.
GEORGE BURRELL L.S. ASHLAND, ORE.
NOV. 24, 1968

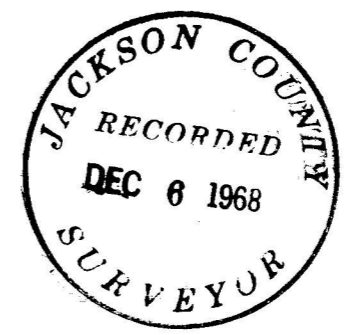

REGISTERED
OREGON
LAND SURVEYOR

George Burrell
JULY 10, 1964
GEORGE R. BURRELL
638

SURVEY NARRATIVE TO COMPLY WITH O.R.S. 209.250

REVISED BY CHAPTER 555, O.L. 1963

FOR: E. S. Morgan
418 West 25th Avenue
San Mateo, Calif. 94403

PURPOSE: To monument the corners of the tract described in Volume 154, Page 268, Deed Records, Jackson County, Oregon and to determine the relationship of the East line of the tract described in Vol. 554/561, Deed Records, Jackson County, Oregon with the West line of said first tract.

PROCEDURE: The monuments found at the corners of the tract described in Vol. 554/561, Deed Records, Jackson County, Oregon are all stamped (R.S. 298) further research revealed they were set by Fredrick Warner, Surveyor, for Safeway Stores, Inc., (survey unrecorded).

The 1/2 inch pipe found at the Southeast corner of the tract described in Volume 154/268 was accepted as the true corner on the basis of proportional measurement along the North line of Siskiyou Blvd. as shown on accompanying map. The Northeast corner of this tract was established according to Deed Record as was the Southwest corner of said tract, both of which agree with the Warner Survey for Safeway Stores, Inc. where in the Northwest Corner of the tract herein surveyed and the Southeast corner of Lot 34, HUNSAKERS ADDITION were reestablished.

REGISTERED
OREGON
LAND SURVEYOR

George Burrell

JULY 10, 1964
GEORGE R. BURRELL
638

JACKSON COUNTY
RECORDED
DEC 8 1968
SURVEYOR