

IRRIGATION DITCH

5/8" IRON BOLT EXPOSED 3" IN SOUTHEAST CORNER CONCRETE WALL.

N. 35° 35' 50" W.
31.17

SET 1" x 30" GALV. IRON PIPE 19" BELOW GROUND SURFACE FOR N.W. CORNER DLC NO. 73.

SPIKE IN POWER POLE # 17, 3 1/2" ABOVE GROUND

FOUND POWER POLE # 18 PER RE-ESTABLISH NOTES S. 6° 30' W., 13.7 FEET

N. 84° 18' W.

SET 1/2" GALV. IRON PIPE 19" BELOW GROUND SURFACE FOR NORTHEAST CORNER DLC NO. 69

SET 5/8" x 30" RE-BAR 14" BELOW GROUND SURFACE

30.00

S. 00° 16' E.

NORTH

REGISTERED OREGON LAND SURVEYOR
Everett L. Swain
JULY 8, 1966
EVERETT L. SWAIN
759

MAP OF SURVEY

TO RE-ESTABLISH THE NORTHWEST CORNER OF DLC NO. 73 AND THE NORTHEAST CORNER OF DLC NO. 69, T. 37 S. R. 2 W. W.M. JACKSON COUNTY OREGON

FOUND 1/2" GALV. IRON PIPE 2" BELOW EDGE ROAD SURFACE FOR SOUTHEAST CORNER DLC NO. 69

SURVEYED BY: EVERETT L. SWAIN, PROFESSIONAL LAND SURVEYOR
PARTY CHIEF: EVERETT L. SWAIN,
CHAINMAN: BENNETT AUSTIN
CHAINMAN: JACK HUSTON

DATE: OCTOBER 18, 1968
SCALE: 1" = 100'
BASIS OF BEARING: § ROSS LANE, NORTH ROSS LANE WESTERLY.

JACKSON COUNTY
RECORDED
DEC 9 1968
SURVEYOR

Survey Narrative to Comply with Paragraph 209.250
Oregon Revised Statutes

Mark E. Boyden
Jackson County Surveyor
Medford, Oregon

In re: The restoration of obliterated Donation Land
Claim corners in Township 37 South, Range 2
West of the Willamette Base and Meridian,
Jackson County, Oregon.

Northwest corner DLC No. 73

Found the $1\frac{1}{2}$ inch galvanized iron pipe, per the county surveyors records, disturbed. All reference monuments are destroyed except the power pole #16. I set a 1x30 inch galvanized iron pipe 19 inches below the ground surface, per the record call from said power pole. I ran a random traverse to the Southeast corner of DLC No. 69 and to the Northwest corner of DLC No. 88. The computed distance between said corners checked very good in relation to information furnished by the County Surveyors office. From this corner

a $\frac{5}{8}$ inch iron bolt exposed 3 inches in the Southeast corner of a concrete wall, bears N. $38^{\circ}35'50''$ W., 311.73 feet.

the center of a power pole # 16 bears S. $06^{\circ}30'$ W., 13.7 feet.


a $1\frac{1}{2}$ x30 inch galvanized iron pipe at the Northeast corner of DLC No. 69 and being 19 inches below ground surface, bears S. $00^{\circ}16'$ E., 62.31 feet.

Northeast corner DLC No. 69

Found the $1\frac{1}{2}$ inch galvanized iron pipe with the $\frac{3}{4}$ inch galvanized iron pipe inside, per county surveyors records, disturbed. I checked the record distance of 62.31 feet to the hole left by the $\frac{3}{4}$ inch pipe, from the Northwest corner DLC No. 73. The error was less than 0.1 of a foot. All the references are destroyed. Therefore I set a $1\frac{1}{2}$ x30 inch galvanized iron pipe 19 inches below the ground surface, the record distance of 62.31 feet from the Northwest corner DLC No. 73 and on a straight line between the Northwest corner DLC No. 73 and the Southeast corner DLC No. 69, from which

a $\frac{5}{8}$ x30 inch re-bar, 14 inches below the ground surface, bears N. $84^{\circ}18'$ W., 30.00 feet.

a 1x30 inch galvanized iron pipe at the Northwest corner DLC No. 73 and being 19 inches below ground surface, bears N. $00^{\circ}16'$ W., 62.31 feet.

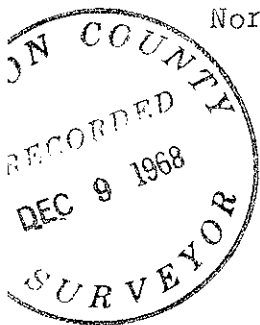

October 18, 1968

Everett L. Swain
Professional Land Surveyor