
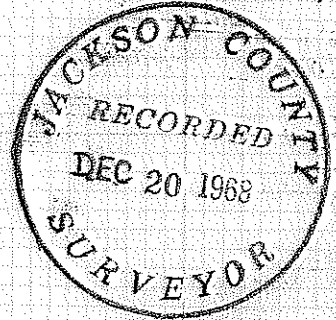


1688 3891

Survey For:
CITY OF GOLD HILL
Located in Blocks 13 & 14
of the Original Townsite of
GOLD HILL, Oregon
in the NW 1/4, Section 22,
T.36S.R.3W., W.M.
By: Mark E. Boyden
Dec. 5, 1968

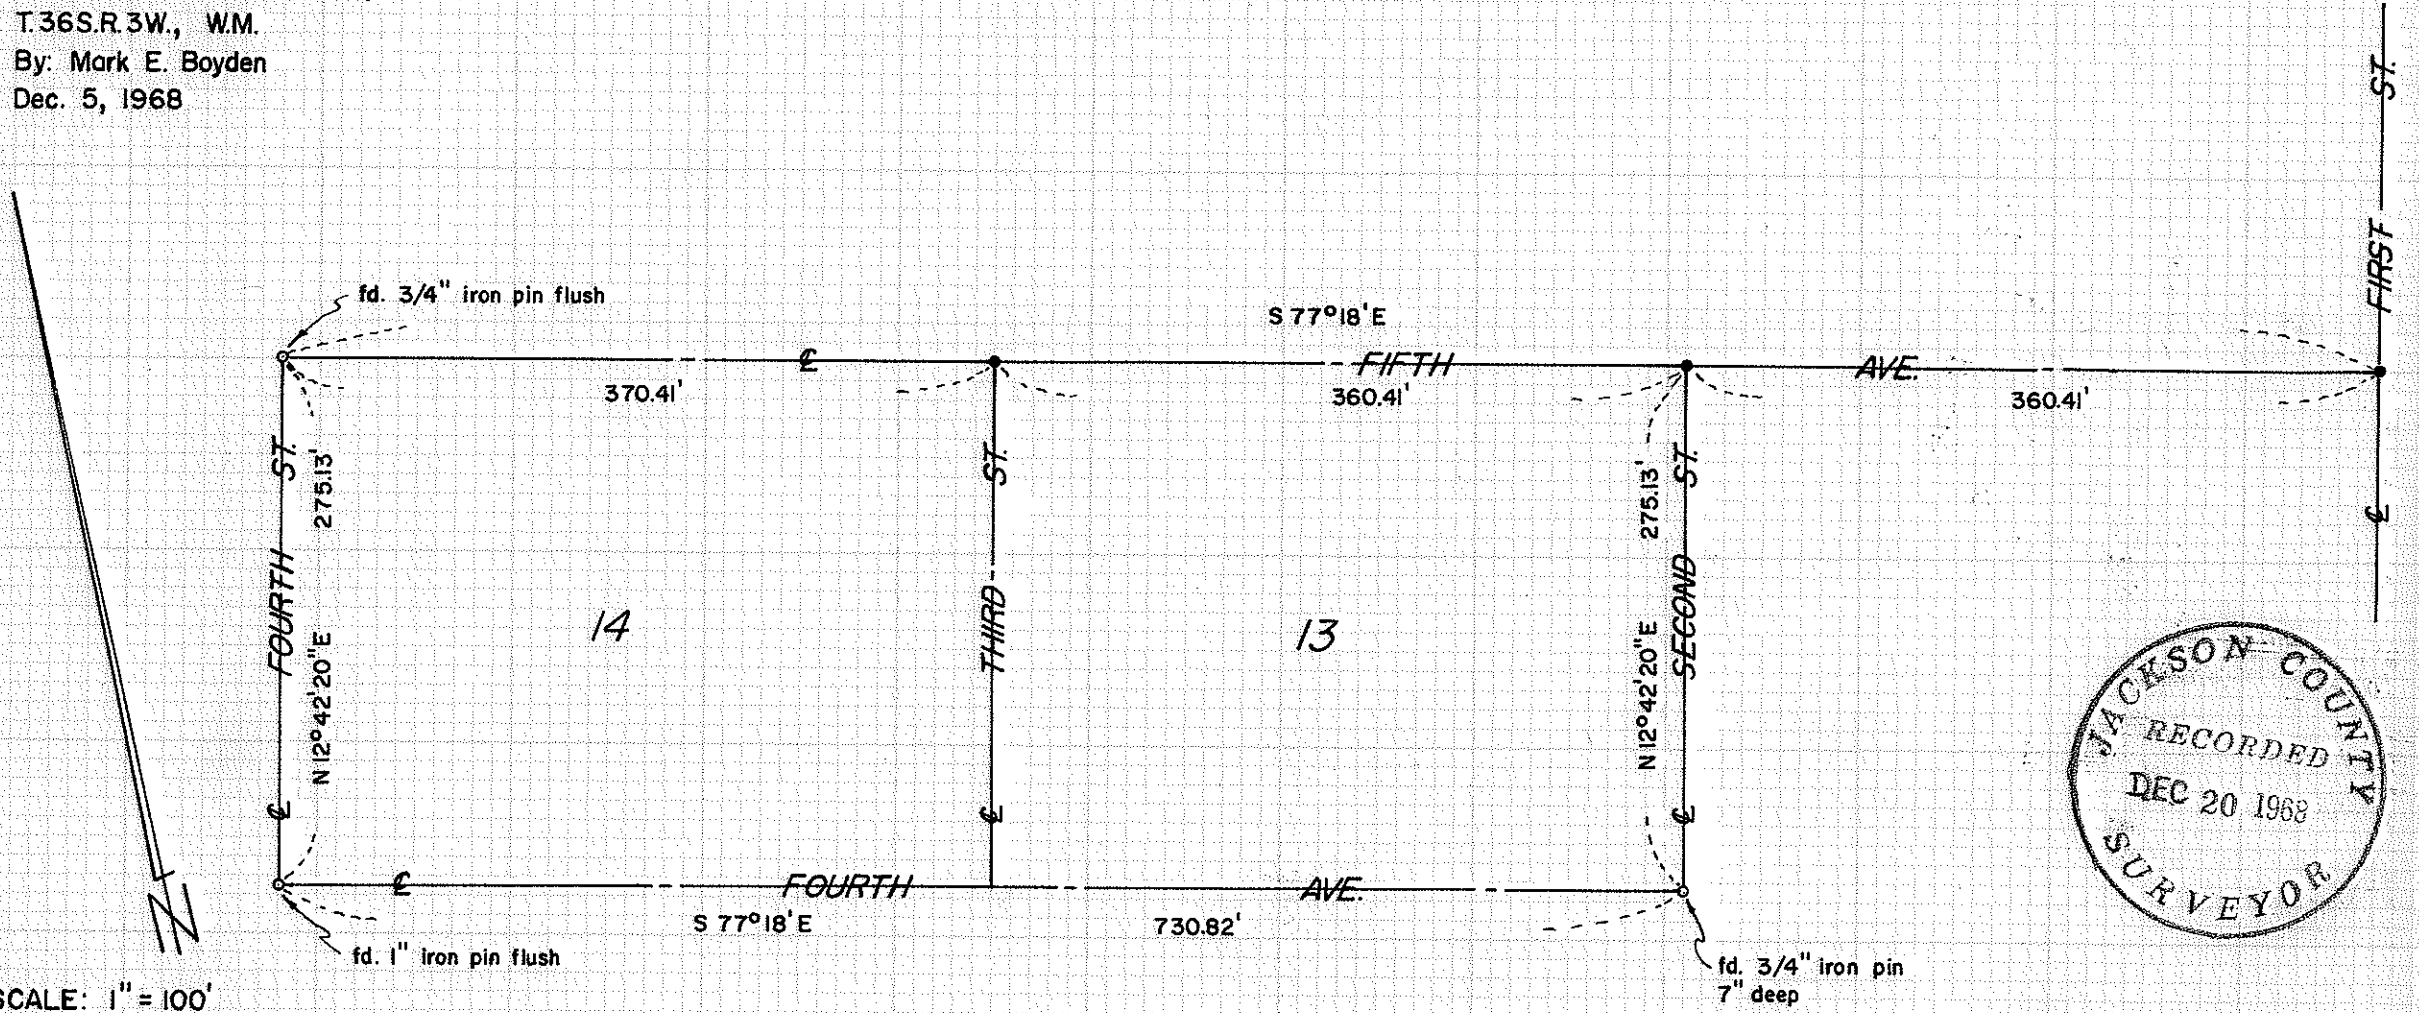

SCALE: 1" = 100'
• set 3/4" X 30" iron pin flush

Basis of Bearings:
Recorded Survey No. 1875

REGISTERED
OREGON
LAND SURVEYOR

Mark E. Boyden

OVEMBER 9, 1961
MARK E. BOYDEN
261

3891

SURVEY NARRATIVE TO COMPLY WITH O.R.S. 209.250

FOR: City of Gold Hill
City Hall
Gold Hill, Oregon

PURPOSE: To monument street centers on Fifth Avenue in the original townsite of Gold Hill, Oregon.

PROCEDURE: From street center control monuments previously utilized on Recorded Survey Nos. 2283 and 2717, monumented Fifth Avenue parallel with Fourth Avenue and First, Second and Third Streets parallel with Fourth Street.

December 5, 1968

REGISTERED
OREGON
LAND SURVEYOR
Mark E. Boyden
NOVEMBER 9, 1967
MARK E. BOYDEN
281

JACKSON COUNTY
RECORDED
DEC 20 1968
SURVEYOR