

1068

SOUTH BOUNDARY OF LOT 10 DOCTORS PARK TRACTS (RECORDED)

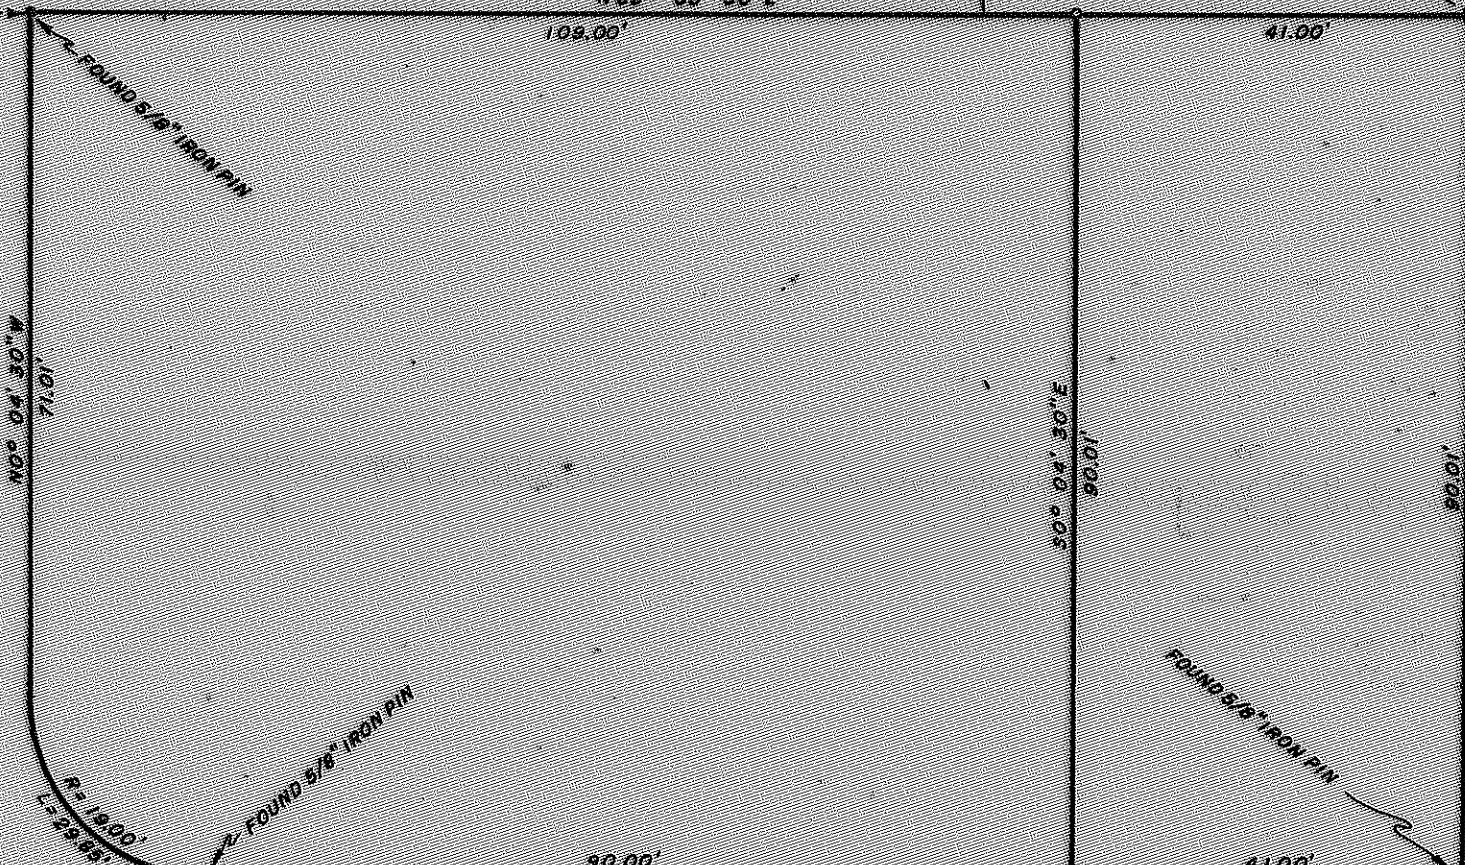
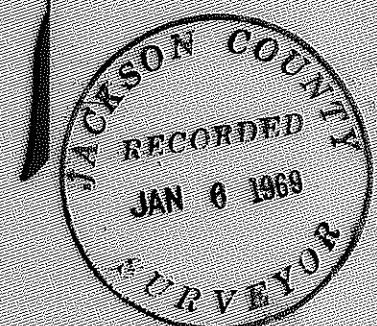
N 22° 55' 30"E

108.00'

41.00'

MURPHY ROAD

E DOCTORS PARK DRIVE

S.W. CORNER OF D.L.C. NO. 59
FOUND BRASS DISCFOUND BRASS DISC
SET IN CONCRETE
INITIAL POINT "DOCTORS
PARK SUBDIVISION (RECORDED)

MAP OF SURVEY

LOCATED IN

S.W. 1/4 OF SECTION 28, T. 37 S., R. 1 W., W.M.

JACKSON COUNTY, OREGON

FOR

DR. RALPH THOMPSEN

J. A. HOFFBUHR, REG. L.S., MEDFORD, OREGON

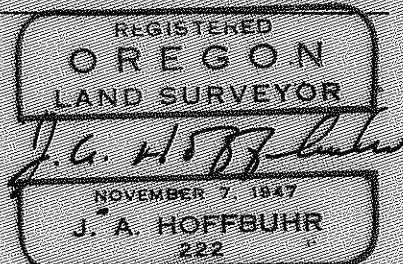
SCALE: 1"=20'

SEPT. 8, 1968

BASIS OF BEARING - DOCTORS PARK SUBDIV.

o=SET 5/8" X 24" IRON REINFORCING PIN

3901



Survey Narrative To Comply With Paragraph 209.250
Oregon Revised Statutes

SURVEY FOR: Dr. Ralph Thompson
2940 Hillcrest
Medford, Oregon

LOCATION: Tract situate in the Southwest One Quarter (1/4)
of Section 28, Township 37 South, Range 1 West,
Willamette Meridian, Jackson County, Oregon.

PURPOSE: To monument the corners and describe the East
41.00 feet of the tract as shown on the attached
map.

PROCEDURE: The original pins set for this tract and the initial
point of Doctors Park Subdivision were used for this survey.

Basis of bearings--Doctors Park Subdivision.

December 31, 1968

J. A. Hoffbuhr
Registered Land Surveyor

