


Written narrative to accompany plat for survey NO. _____
 Survey of Barnett Road Extension as previously constructed.
 For Mr. A. C. Pierce. Pierce Heights, Medford, Oregon.
 Completed Jan. 23, 1965. Federal Aid size plan and profile turned in
 to County Engineer's office previously. This map showing location
 of 5/8" x 24" bars set for curve and P.I. Controls.

The control information was obtained from the County Engineer's
 office from a survey (construction type) made by their crew showing
 the south line of Barnett Extension to be on the section line,
 Using this information we picked up at the N.E. Corner of Donation
 Land Claim No. 56, T. 37 S. R 1. W and ran South 89°46'45" East
 869.73 feet to the beginning of a curve

We then set up controls to fit the existing roadway as built
 and ran curves and tangents to fit, setting reference 5/8" bars
 at curve points and some of the P.I's as shown on the attached plat.

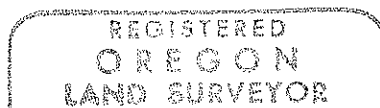

L. N. Dow

