
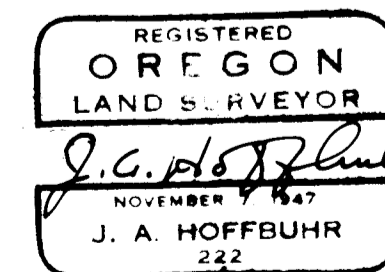


- ① FOUND A 1" GALV. IRON PIPE IN A MOUND OF STONE  
A BLACK OAK W/NEW BT. TAG - N 30 1/2° W. 29.7'  
AN OLD YELLOW PINE BT. ON GROUND AND BLAZED - S 89 1/2° E 15.2'  
A BLACK OAK B.T. W/SCRIBES VISIBLE - S 55 1/2° W 56.8'
- ② FOUND 1" GALV. IRON PIPE W/ WOOD PLUG, TACK & ORIGINAL BEARING TREES.  
A YELLOW PINE BEARS N 60° 15' W. 8.6'  
A BLACK OAK BEARS S 46° 15' E 16.3'
- ③ FOUND 1" IRON PIPE W/ 1/2" EXPANDER ON TOP FILLED W/ POT MEATAL  
AND STAMPED T 33 S R 2 E 8-9-17-18 CS 1960  
A WHITE OAK BEARS N 30° E 18.4. A BLACK OAK BEARS S 18° E 54.9'  
A BLACK OAK BEARS S 72 1/2° W 32.5'. A BLACK OAK BEARS N 29 1/2° W 23.5'
- ④ FOUND 1" GALV. IRON PIPE AND ORIGINAL BEARING TREES.  
A RED FIR BEARS N 47° 15' W 26.1'  
A RED FIR BEARS S 47° 50' E 80.7'
- ⑤ FOUND 2" GALV. IRON PIPE AND 3 BEARING TREES.  
A RED FIR SCRIBED C.S.B.T. BEARS N 73° 30' E 53.0'  
A RED FIR SCRIBED C.S.B.T. BEARS S 66° 30' W 25.0'  
A RED FIR SCRIBED C.S.B.T. BEARS S 11° 15' E 5.9'
- ⑥ FOUND 1" GALV. IRON PIPE AND ONE BEARING TREE.  
A RED FIR SCRIBED C.S.B.T. BEARS N 52° W 73.1'
- ⑦ FOUND 2" IRON PIPE W/ BRASS DISK MARKED U.S.G.L.O. T 33 SR 2 E SEC 17-18-19-20  
AND A 2" GALV. IRON PIPE 0.16' NORTH AND 0.14' WEST OF THE G.L.O. MONUMENT.  
A YELLOW PINE BEARS N 82° 15' E 59.4. A RED FIR SCRIBED C.S.B.T. BEARS S 21° W 28.1'  
A BLACK OAK BEARS S 69° 45' E 55.2'. A BLACK OAK SCRIBED C.S.B.T. BEARS N 45° W 75.8'
- ⑧ FOUND 1 1/2" IRON PIPE SET IN MOUND OF STONE AND 2 BEARING TREES.  
A BLACK OAK SCRIBED C.S.B.T. BEARS S 26° E 59.8'  
A BLACK OAK SCRIBED C.S.B.T. BEARS N 89 1/2° W 40.3'
- ⑨ SET 2" IRON PIPE WITH A BRASS DISK MARKED N.W. 1/16 SEC. 17 1968 J.A. HOFFBUHR.  
A 10" CEDAR BEARS S 74° 30' W 11.0'  
A 8" FIR BEARS S 51° 00' E 40.7'
- ⑩ SET 2" IRON PIPE WITH A BRASS DISK MARKED CN 1/16 SEC. 17 1968 J.A. HOFFBUHR.  
A 18" CEDAR BEARS N 63° 00' W 66.4'  
A 12" FIR BEARS S 64° 30' W 72.2'
- ⑪ SET 2" IRON PIPE WITH A BRASS DISK MARKED N.E. 1/16 SEC. 17 1968 J.A. HOFFBUHR.  
A 12" FIR BEARS S 31° 00' E 39.5'
- ⑫ SET 2" IRON PIPE WITH A BRASS DISK MARKED C-W 1/16 SEC. 17 1968 J.A. HOFFBUHR.  
A 8" CEDAR BEARS N 63° 30' W 8.8'  
A 14" FIR BEARS N 26° 00' E 45.4'
- ⑬ SET 2" IRON PIPE WITH A BRASS DISK MARKED C 1/4 SEC. 17 1967 J.A. HOFFBUHR.  
A 15" CEDAR BEARS S 41° 05' E 108.6'  
A 15" FIR BEARS S 75° 50' W 97.9'
- ⑭ SET 2" IRON PIPE WITH A BRASS DISK MARKED C-E 1/16 1968 J.A. HOFFBUHR.  
A 9" FIR BEARS N 46° 00' W 21.0'  
A 9" FIR BEARS N 16° 00' E 16.8'
- ⑮ SET 2" IRON PIPE WITH A BRASS DISK MARKED S.W. 1/16 1968 J.A. HOFFBUHR.  
A 14" CEDAR BEARS N 77° 30' W 85.8'  
A 16" CEDAR BEARS N 12° 30' W 89.2'
- ⑯ SET 2" IRON PIPE WITH A BRASS DISK MARKED C-S 1/16 1969 J.A. HOFFBUHR.  
A 11" CEDAR BEARS S 73° 00' W 18.9'  
A 7" FIR BEARS N 9° 00' W 6.0'

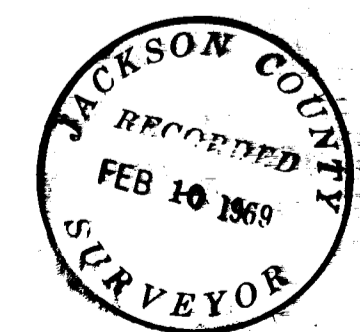

MAP OF SURVEY  
LOCATED IN  
SECTION 17, T. 33 S., R. 2 E., W.M.  
JACKSON COUNTY OREGON  
FOR  
MARK A. SHIPLEY

J.A. HOFFBUHR, REG. L.S., MEDFORD, OREGON  
SCALE: 1" = 500' JAN. 21, 1969  
BASIS OF BEARING - R/S NO. 2885

Survey Narrative To Comply With Paragraph 209.250  
Oregon Revised Statutes

SURVEY FOR: Mark A. Shipley  
Evergreen Ranch  
Star Route 230  
Prospect, Oregon

LOCATION: Section 17, Township 33 South, Range 2 East,  
Willamette Meridian, Jackson County, Oregon.

PURPOSE: To subdivide Section 17, in order to establish  
the positions of the interior One Sixteenth  
(1/16) Corners as indicated on the map.

PROCEDURE: The Section Corners were located from the references  
shown on the map. The Section Corner locations were then tied by  
using a set of tellurometers for distance determination and a T-2  
Theodolite for angular measurement. The perimeter distances are  
the results of inverse computations between the coordinated corners.  
The results of the sectional subdivision are as indicated on the  
map. The interior corners numbered 9, 10, 11, 12, 13, 14, 15 & 16  
were established and referenced as indicated on the map.

Basis of bearings--Recorded Survey No. 3885.

January 31, 1969

J. A. Hoffbuhr  
Registered Land Surveyor

