

Revised: 10-22-1965
 Revised: 3-14-1969




LOCATION MAP OF PROPERTY

situate in
 S.W. 1/4 of Section 32, T.36S., R.1W., W.M.
 Jackson County Oregon

for
 W.V. Johnston
 J.A. Hoffbuhr L.S. Medford, Oregon
 Scale: 1"=200' April 23, 1965

Bearings per Rec. Survey #2586
 o = Set 3/8" x 24" iron reinforcing pin
 ● = Found 3/8" iron pin

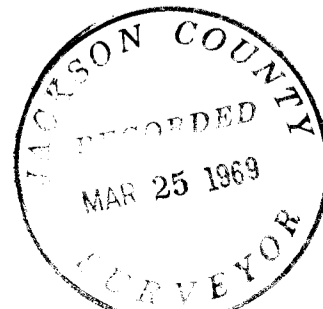

J.A. Hoffbuhr


Survey Narrative To Comply With Paragraph 209.250
Oregon Revised Statutes

SURVEY FOR: W. V. Johnston
2631 Hillcrest Road
Medford, Oregon

LOCATION: Tract situate in the Southwest One Quarter (1/4)
of Section 32, Township 36 South, Range 1 West,
Willamette Meridian, Jackson County, Oregon.

PURPOSE: To monument the corners and describe additional
tracts. It is the purpose of this recording to place of record the
additional tracts not heretofore recorded by Recorded Survey Nos.
2775 and 3383. The controls of these two recorded surveys were used
for this continuation.

March 21, 1969

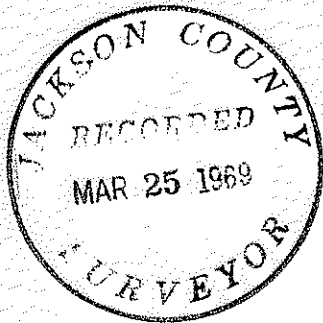

J. A. Hoffbuhr
Registered Land Surveyor

