

JACKSON COUNTY
 RECORDED
 MAR 27 1969
 SURVEYOR

EVERETT L. SWAIN
 SURVEYOR

MAP OF SURVEY
 LOCATED IN
 40'x170' LOT 8 IN NW 1/4 OF SEC. 30, T. 39S. R. 2E. W.B.M
 JACKSON COUNTY OREGON

KARL WINDBIZLER

EVERETT L. SWAIN, R.L.S. ASHLAND, OREGON
 SCALE 1" = 20' DEC. 2, 1968
 BASIS OF BEARING RECORDED SURVEY NO. 3772
 0 SET 1/2" x 30" GALV. IRON PIPE WITH TAG L.S. 759
 0 FOUND 1/2" INCH GALV. IRON PIPE WITH TAG L.S. 759, UNLESS OTHERWISE NOTED.
 REVISED: 3-24-69

SURVEY NO. 3970


Survey Narrative to Comply with Paragraph 209.250
Oregon Revised Statutes

Survey For: Karl Windbigler
1929 Verda Street
Ashland, Oregon

Location: Government Lot 8 in the Northwest one-quarter of
Section 30, Township 39 South, Range 2 East of the
Willamette Base and Meridian, Jackson County,
Oregon.

Purpose: To survey, monument and describe the two parcels
as shown on the attached map.

Procedure: From previous survey control compiled by this office,
proceeded to monument the parcels as shown on the
attached map.

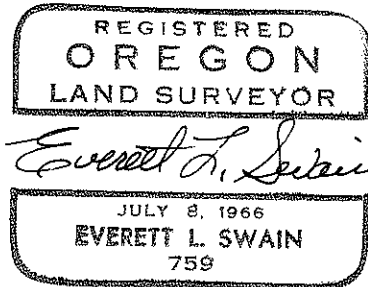

March 25, 1969

Everett L. Swain
Professional Land Surveyor
Ashland, Oregon

