

SURVEY IN D.L.C. 45 & GOV'T. LOTS 9 & 10 LOCATED IN SECTION 15, TWP. 36 S., RANGE 2 W., W.M. JACKSON COUNTY, ORE.

EXECUTED FOR JOHN F. MACE

SCALE 1" = 200'

SURVEY BY CHARLES H. HURST MEDFORD, OREGON

- LEGEND
- SET 5/8" X 24" IRON PINS
 - FD. 5/8" IRON PINS PER REG. SURVEY NO. 3719

REGISTERED OREGON LAND SURVEYOR

Charles H. Hurst

OCTOBER 30, 1959 CHARLES H. HURST 483

FD. SE COR. DLC 45 CONG. MON. - BR. DISC

APR 28 1969

OREGON REVISED STATUTES

Survey for: John F. Mace
Highbanks Road
Central Point, Oregon

Survey by : Charles H. Hurst, L.S.
28 North Oakdale
Medford, Oregon


Bearing : Based on meridian of Recorded Survey No. 1486

Purpose : To separate, define and monument the tract shown.

PROCEDURE

An extension of recorded survey No. 2842 utilizing survey control previously established at that time. Tract is monumented at locations designated by the client.

April 28, 1969

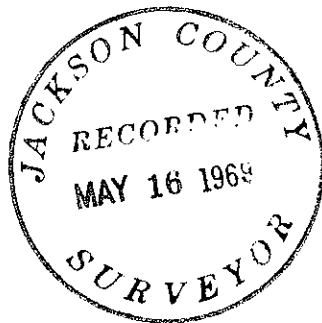

Charles H. Hurst

