

JACKSON COUNTY
RECORDED
MAY 20 1969
SURVEYOR

REGISTERED
OREGON
LAND SURVEYOR
J. A. Hoffbuhr

MAP OF SURVEY
LOCATED IN
S.W. 1/4 OF SECTION 26, T. 38 S., R. 1 W., W.M.
JACKSON COUNTY OREGON
FOR
C. O. WEBBER

J. A. HOFFBUHR, REG. L. S., MEDFORD, OREGON
SCALE: 1" = 100' MAY 15, 1969
BASIS OF BEARING - R/S NO. 3658
o-SET 5/8" X 24" IRON REINFORCING PIN

3997

SURVEY NO. 3997

Survey Narrative To Comply With Paragraph 209.250
Oregon Revised Statutes

SURVEY FOR: Calvin Webber
6731 Wagner Creek Road
Talent, Oregon


LOCATION: Tract situate in the Southwest One Quarter
(1/4) of Section 26, Township 38 South,
Range 1 West, Willamette Meridian, Jackson
County, Oregon.

PURPOSE: To monument the corners and prepare a legal
description of the tract of land shown on
the attached map.

PROCEDURE: The Jackson County Engineers centerline was
established from existing centerline control and by reason that
the tract lies wholly within the clients ownership there were no
boundary problems. The description was tied to the N.E. Corner
of Donation Land Claim No. 63 as found and shown by Recorded
Survey No. 3658.

Basis of bearings--Recorded Survey No. 3658.

May 19, 1969

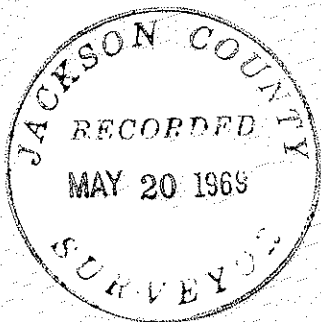

J. A. Hoffbuhr
Registered Land Surveyor

