


PLAT

Of Survey in Lot 7 of RIVERDALE TRACTS, in Sec. 21
 and in the NW 1/4 of the NE 1/4 of Sec. 21, T. 36 S.,
 R. 7 W., W. M., Jackson County, Oregon
 Sept. 5, 1969

Scale 1" = 50'

For:

MR. EARL J. BRANDY
 2020 Robertson Bridge Rd.
 Grants Pass, Oregon

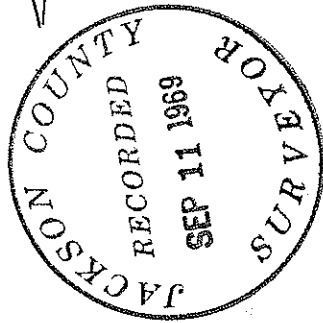

REGISTERED
 OREGON
 LAND SURVEYOR

Claude E. Masters
 OCTOBER 24, 1958
 CLAUDE E. MASTERS
 457

4071

SURVEY NO. _____

SURVEY NARRATIVE to comply with Paragraph 209.250, Oregon Revised Statutes.

SURVEY FOR: MR. EARL J. BRAWDY
2020 Robertson Bridge Road
Grants Pass, Oregon

PURPOSE: To survey and monument tract of land in Lot 7 of Riverdale Tracts, in Section 21 and in the Northwest 1/4 of the Northeast 1/4 of Section 21, Township 36 South, Range 4 West, Willamette Meridian, Josephine County, Oregon, per description furnished by Real Estate Agent.

PROCEDURE: Using copy of Original Plat of Riverdale Tracts and copy of Survey 1509, I resurveyed Lot 7 and, finding that monuments found and record distances and bearings agreed with available records, I monumented the described parcel with the results as shown on plat.

REGISTERED
OREGON
LAND SURVEYOR

Claude E. Masters

OCTOBER 24, 1958
CLAUDE E. MASTERS
457

JACKSON COUNTY
RECORDED
SURVEYOR