

SURVEY IN NW.1/4 SEC.10 T.33S., R.2 E. W.M.
FOR
OLSON-LAWYER LUMBER CO.

BY EDWARD MCGINTY
MEDFORD, OREGON
JUNE 24, 1969

SCALE 1" = 120'
● = 5/8" I. PIN SET
○ = 5/8" I. PIN FD

66-51-2

REGISTERED
OREGON
LAND SURVEYOR

Edward A. McGinty
JULY 10, 1969
EDWARD A. MCGINTY
301

JACKSON COUNTY
RECORDED
SEP 16 1969
SURVEYOR

Survey No. 4072


SURVEY NARRATIVE TO COMPLY WITH O.R.S. 209-250.

Survey for: Olson - Lawyer Lumber Co. 66-51-2
White City, Oregon

Survey by: Edward A. McGinty
Reg. Land Surveyor
Medford, Oregon
June, 1969



Basis of Bearing: Survey No. 1100

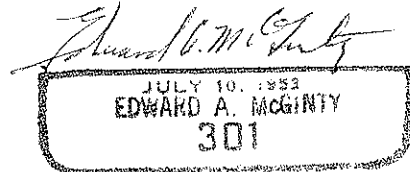

Precedence of Survey:

From survey control found, being of record Survey No. 1100 and Survey No. 3318, surveyed tract as shown on Deed Record Vol. 229 page 575, tie to the center of Section 10. The center of Section 10 was determined on Survey No. 1098, which indicates as shortage east and west along the center of Section. The description of the Tract was apparently described from previous survey No. 1100 and the tie call to the north line of Deed Record Vol. 229, page 575.

Held deed call to said North line and using previous survey controls, monumented Tract as shown.

Monuments found being 5/8 in. iron pins, set approx. flush with the surface. Monuments set being 5/8 x 24 in. iron pins, set approx. flush with the surface.

