

Butte Falls, Oregon  
September 12, 1969

County Surveyor  
Jackson County Courthouse  
Medford, Oregon

Dear Sir;

Please record following in Public Land Surveys.  
SUBJECT; Corner common to Sections 29,30,31,32, T.35S,R3E,W.M.  
OBJECT; Remonument.

Found following; Stumphole NW BT (Fir)  
" SE BT "  
charred Cedar SW BT  
Depression NE BT

All old trees badly burned or dead by Bowen Creek Burn,  
second growth timber on site.

Old blazes intersect from N-S & E-W.

Chainage to corner 1 mile North along blazes is close to  
calls.

Chainage to  $\frac{1}{4}$  corner (iron Pin) to East on blazes is close  
to calls.



Corner used by Private & Government timber cruiser and engineers  
prior to 1937.

Corner used for logging boundaries 1930 & 1938.

$\frac{1}{4}$  corner to South is gone. Section corner 1 mile South bears  
several degrees to West.  $\frac{1}{4}$  corner to West (N $\frac{1}{4}$  S.31) gone, with chain-  
age to West for 1 mile over 700' long. Double proportioned corner  
would not fit old evidence.

Set 5/8"x3' rebar and Aluminum cap

				RS 461		
				<u>30/29</u>		
				31/32		
Scribed 8" D. Fir	N34°W	5.7'	T.35S, R3E	S30	RS 461	BT
" 6" "	N85°E	8.5'	"	S29	"	"
" 8" "	S27°E	28.7'		S32	"	"
" 15" "	S70°W	17.0'		S31	"	"

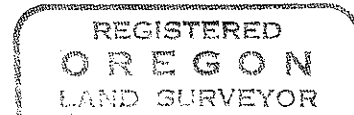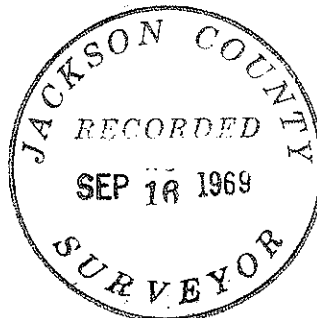

*Duane A. Smeltzer*

