


4096

4096

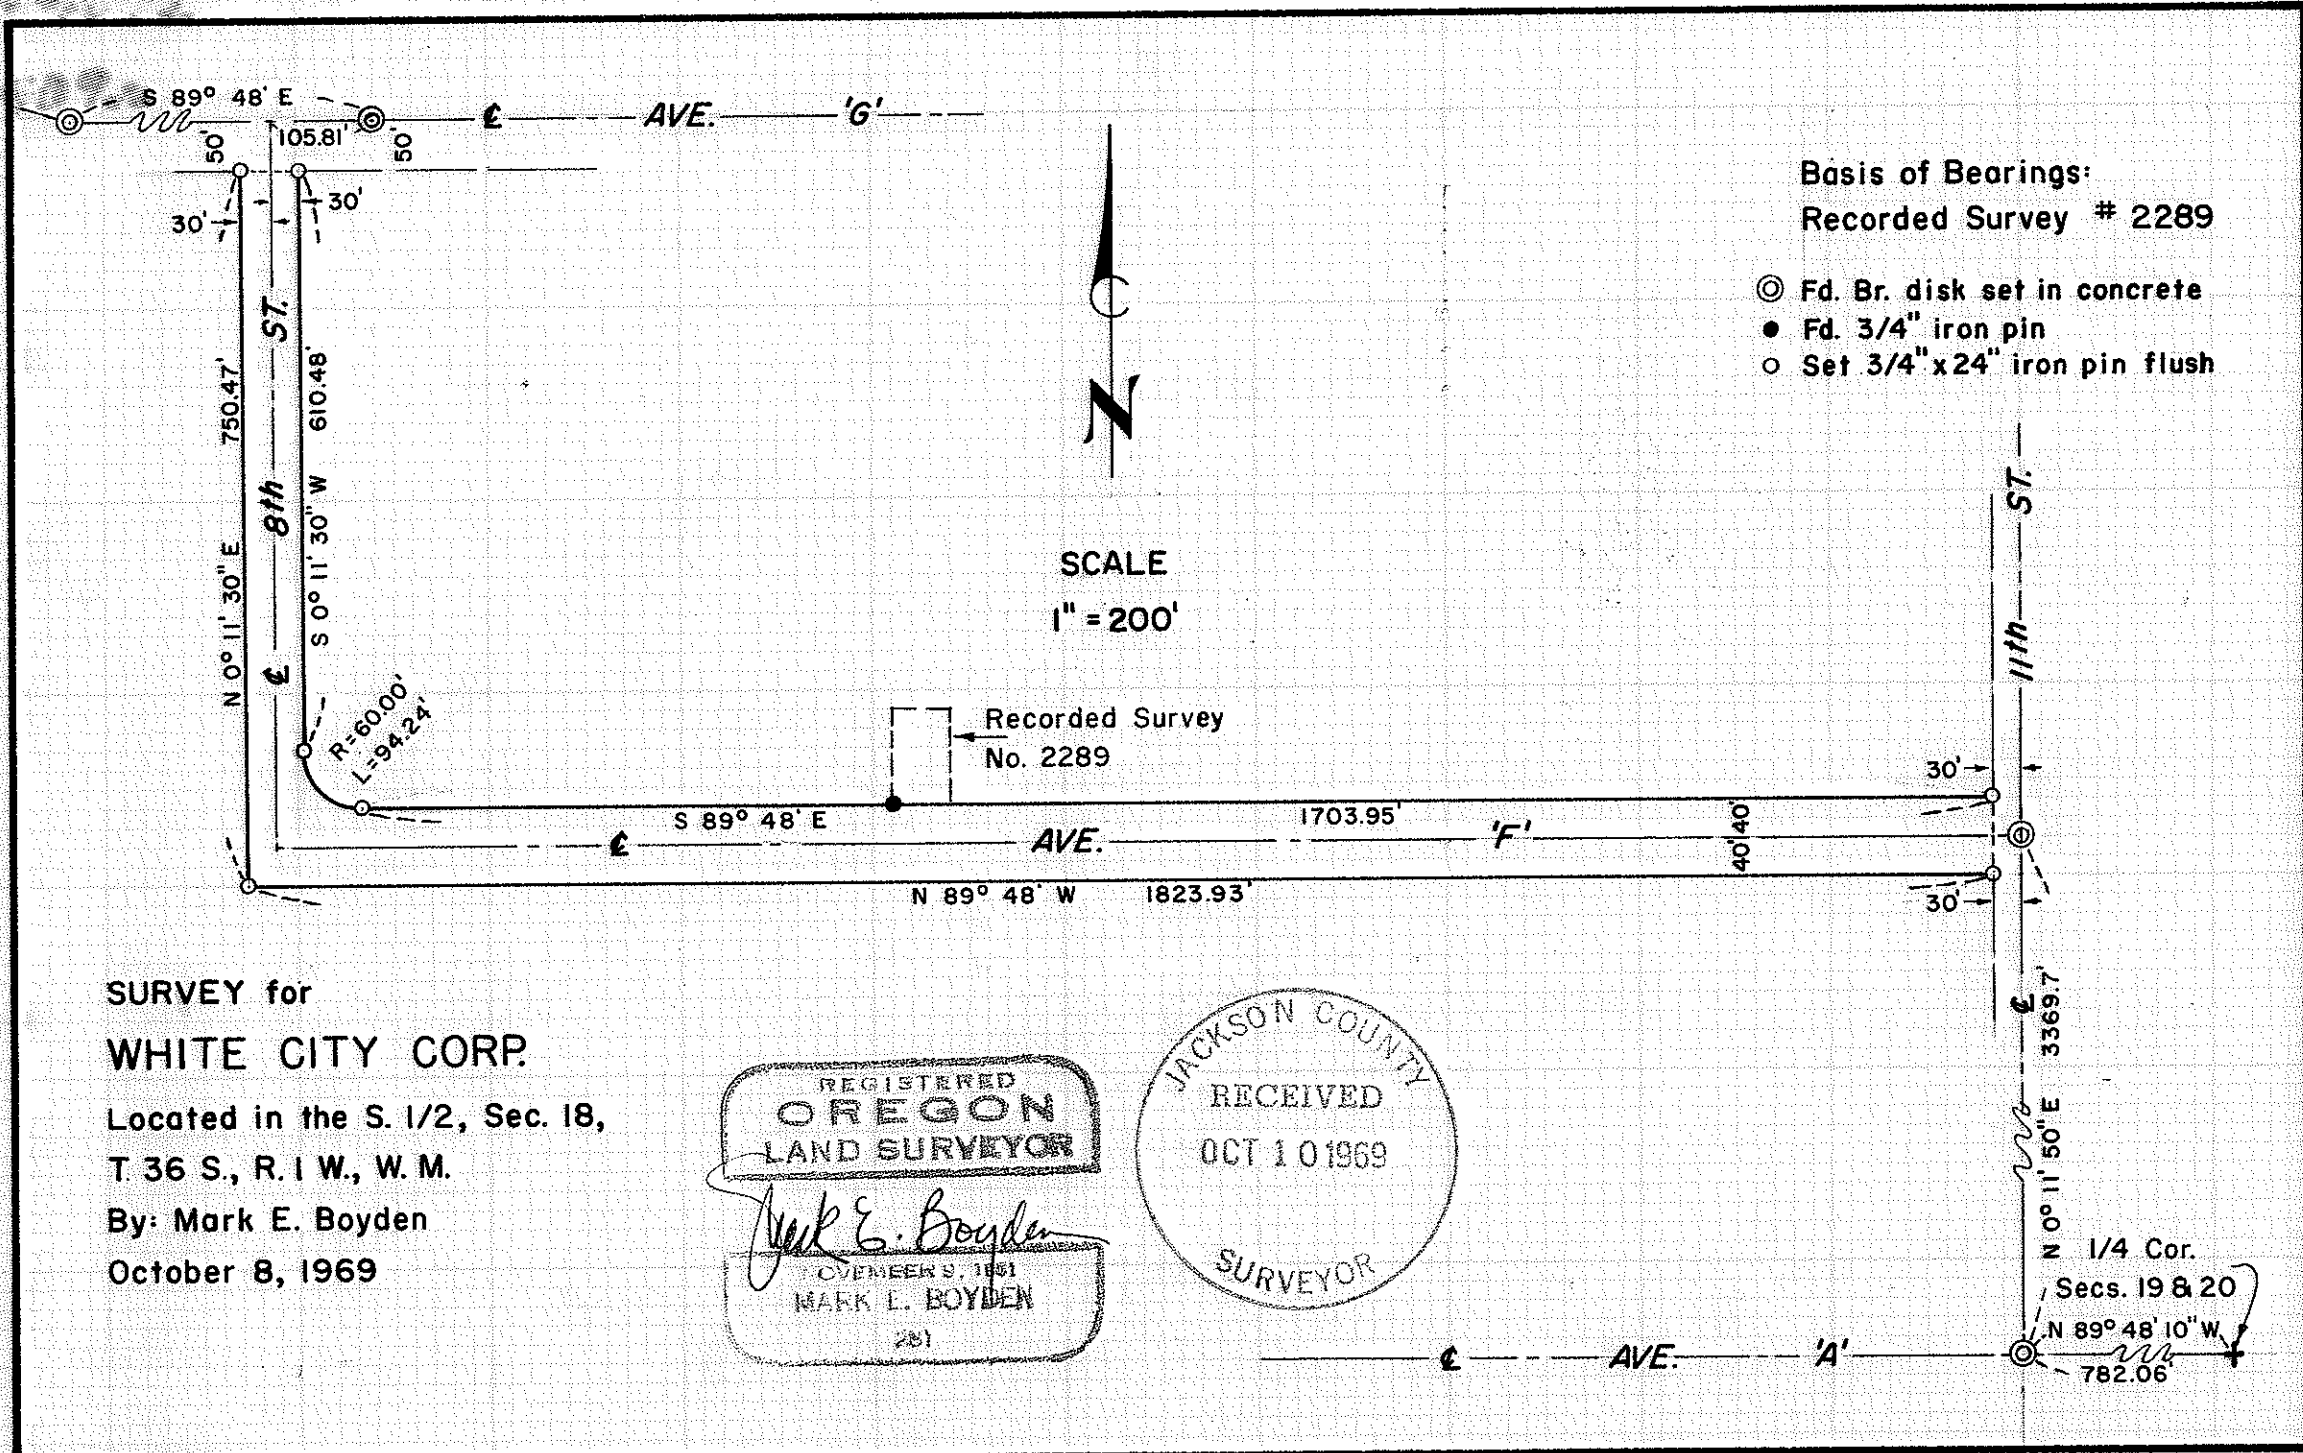

**SURVEY for  
 WHITE CITY CORP.**

Located in the S. 1/2, Sec. 18,  
 T. 36 S., R. 1 W., W. M.

By: Mark E. Boyden  
 October 8, 1969

REGISTERED  
**OREGON**  
 LAND SURVEYOR  
*Mark E. Boyden*  
 NOVEMBER 9, 1951  
 MARK L. BOYDEN  
 281

JACKSON COUNTY  
 RECEIVED  
 OCT 10 1969  
 SURVEYOR

4096

SURVEY NO. 4096

SURVEY NARRATIVE TO COMPLY WITH O.R.S. 209.250

FOR: White City Corporation  
White City, Oregon

PURPOSE: To monument and describe street rights-of-way proposed  
to be conveyed to Jackson County.

PROCEDURE: Found survey monument controls as shown, setting rights-  
of-way monuments as indicated on the map to accompany this report.

October 8, 1969

REGISTERED  
OREGON  
LAND SURVEYOR  
*Mark E. Boyden*  
NOVEMBER 9, 1951  
MARK E. BOYDEN  
281

JACKSON COUNTY  
RECEIVED  
OCT 10 1969  
SURVEYOR