

4101

# SURVEY FOR HERMAN CANNON

N.W. 1/4 SEC. 26, T. 38S., R. 1.W., W.M.

JACKSON COUNTY, ORE.

June 12, 1969

4101

REGISTERED  
OREGON  
LAND SURVEYOR

*Verlyn Thomas*

MAY 13, 1960  
VERLYN THOMAS  
305

JACKSON COUNTY  
RECEIVED  
OCT 17 1969  
SURVEYOR


### LEGEND

- 5/8x24" Iron Pin set flush
- Monument found



SCALE 1" = 40'

SURVEY  
No. 1035

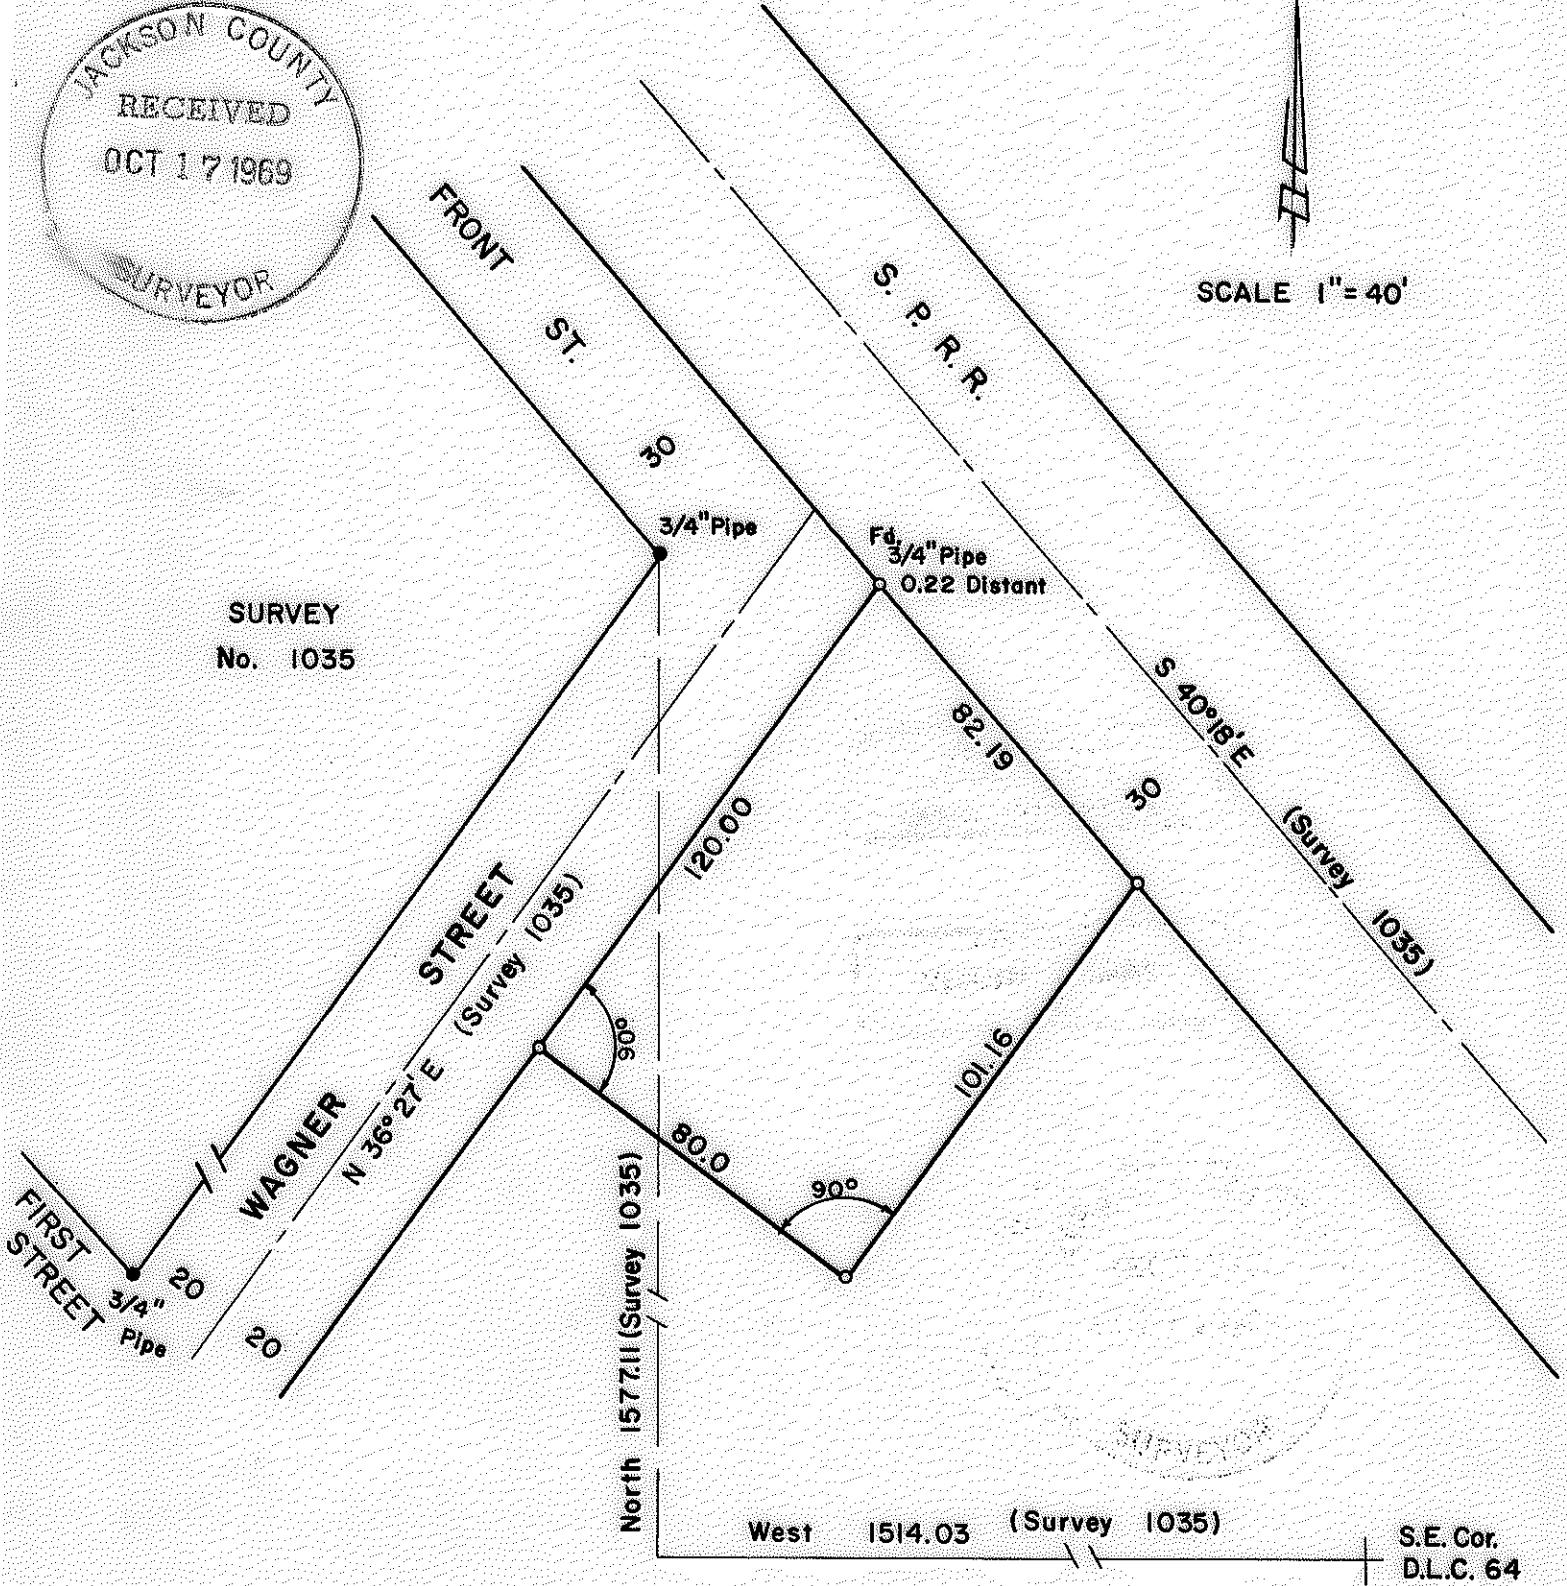

4101

SURVEY NARRATIVE TO COMPLY WITH O.R.S. 209.250  
REVISED BY CHAPTER 555, O.L. 1963.

FOR: Herman Cannon  
109 Wagner Street  
Talent, Oregon

PURPOSE: To survey and monument a parcel at the intersection of the S.P.  
Railroad, and Wagner Street.

PROCEDURE: Recovered iron pipes indicated on Recorded Survey No. 1035, and  
monumented parcel as shown. No survey tie was made to the  
Southeast corner of D.L.C. 64.

REGISTERED  
OREGON  
LAND SURVEYOR

*Verlyn Thomas*

MAY 13, 1960  
VERLYN THOMAS  
505

JACKSON COUNTY  
RECEIVED  
OCT 17 1969  
SURVEYOR